


03-282-B

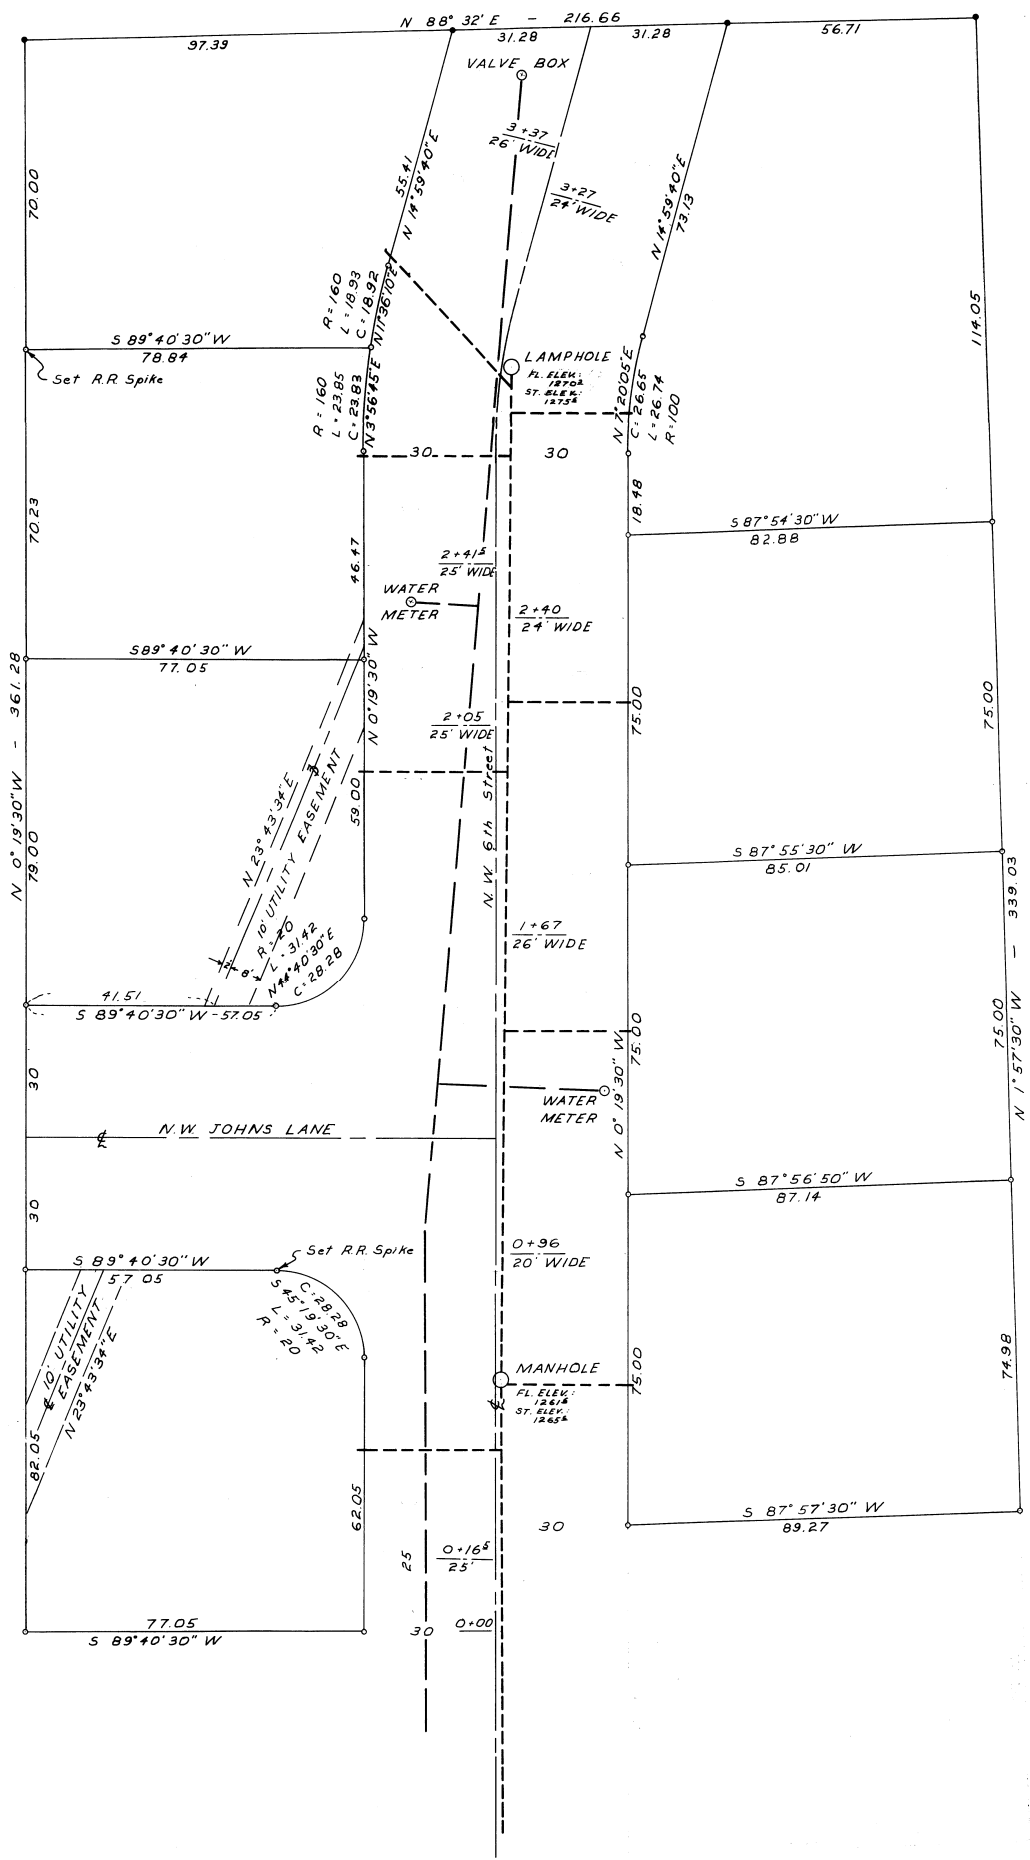

- INDICATES 1/2" I. PIN
- INDICATES 5/8" I. PIN
- SHOWS LOCATION OF SEWERS AS INDICATED ON CONSTRUCTION PLANS, NOT AS BUILT
- ⊥ SHOWS ACTUAL LOCATION OF CURB CUTS & WIDTHS
- INDICATES LOCATION OF WATER LINES AS SHOWN ON CONSTRUCTION PLANS. WATER METERS WERE LOCATED IN FIELD.

REGISTERED
OREGON
 LAND SURVEYOR
Wayne O. Harris
 MAY 6, 1988
WAYNE O. HARRIS
 346

2N32 3DA

WAYNE O. HARRIS & ASSOCIATES

SURVEY FOR
 SHERWOOD & ROBERTS
 STANGIER HILLS ADDITION
 PENDLETON

SCALE	DATE	DRN. BY	DRNG. NO.
1" = 20'	6-12-69	DHK	69-238-C