

CONSTRUCTION WORK SHEET


Owners: Pat & Nancy Wallace

Pendleton, Or

Contractor: Blue Mountain Asphalt Co.


Dixon Bros Plumbing

Staking: Don Staebler Engr. - Surveyor.

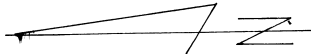

1" = 20'
3-31-88
6-30-88

BLOCK 10
LOT 3
MC FARLAND

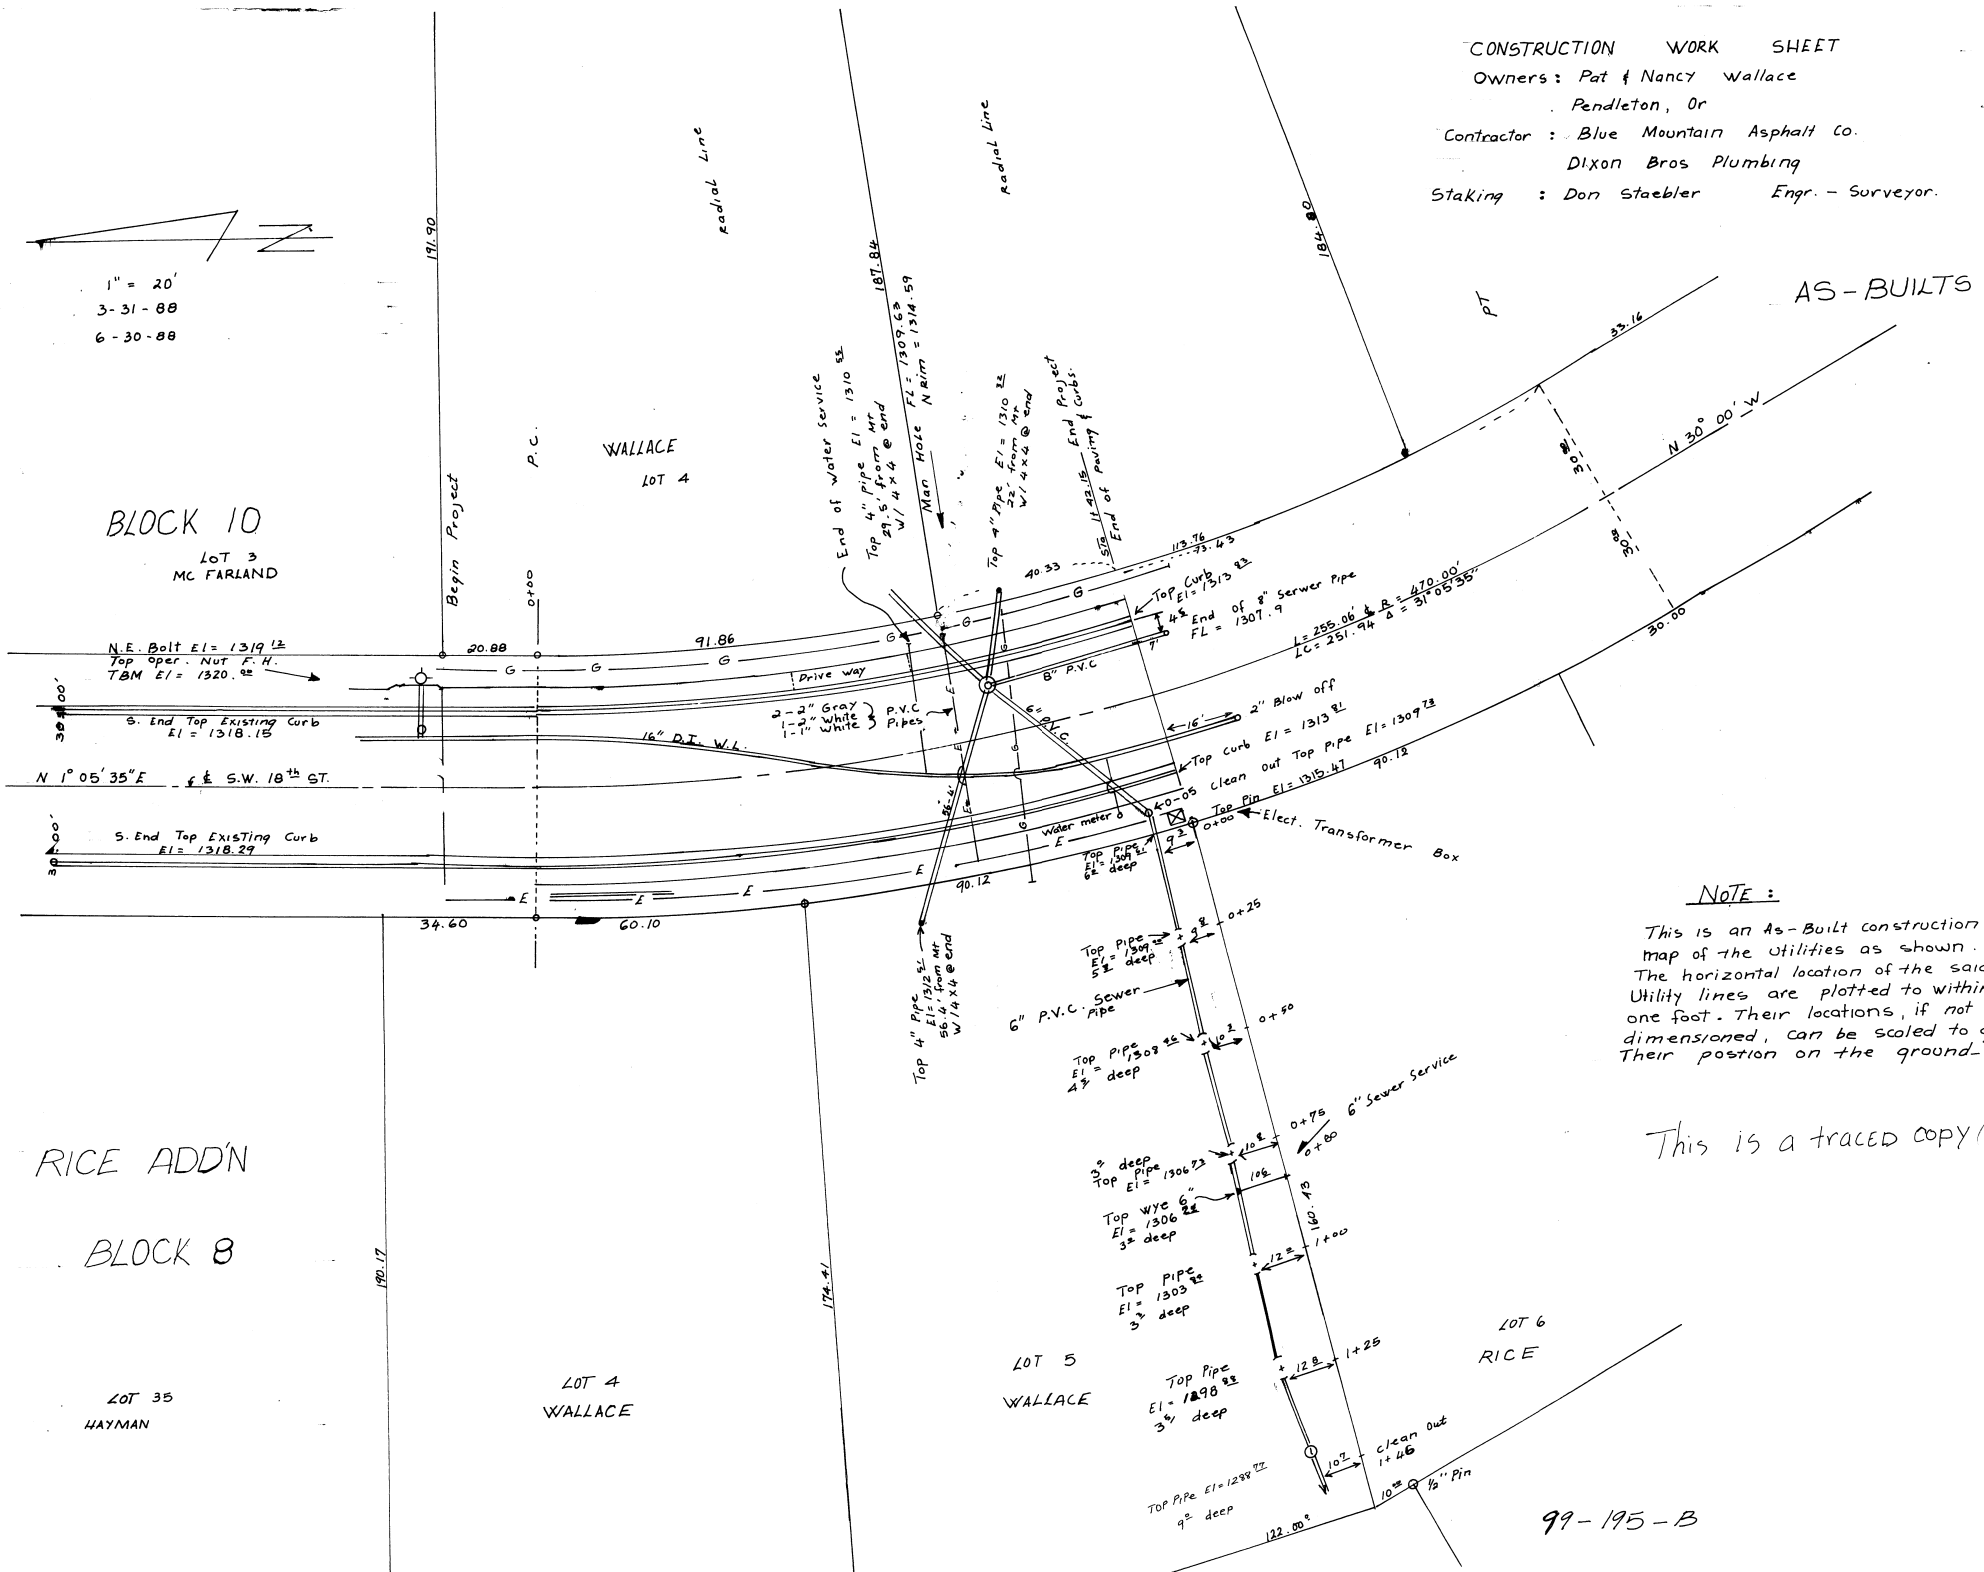

AS-BUILTS

N 1° 05' 35" E & S.W. 10th ST.

S. End Top Existing Curb
El = 1318.29

RICE ADD'N

BLOCK 8

LOT 35
HAYMAN

LOT 4
WALLACE

LOT 5
WALLACE

LOT 6
RICE

NOTE:

This is an As-Built construction map of the utilities as shown. The horizontal location of the said utility lines are plotted to within one foot. Their locations, if not dimensioned, can be scaled to get their position on the ground.

This is a traced copy (77)