
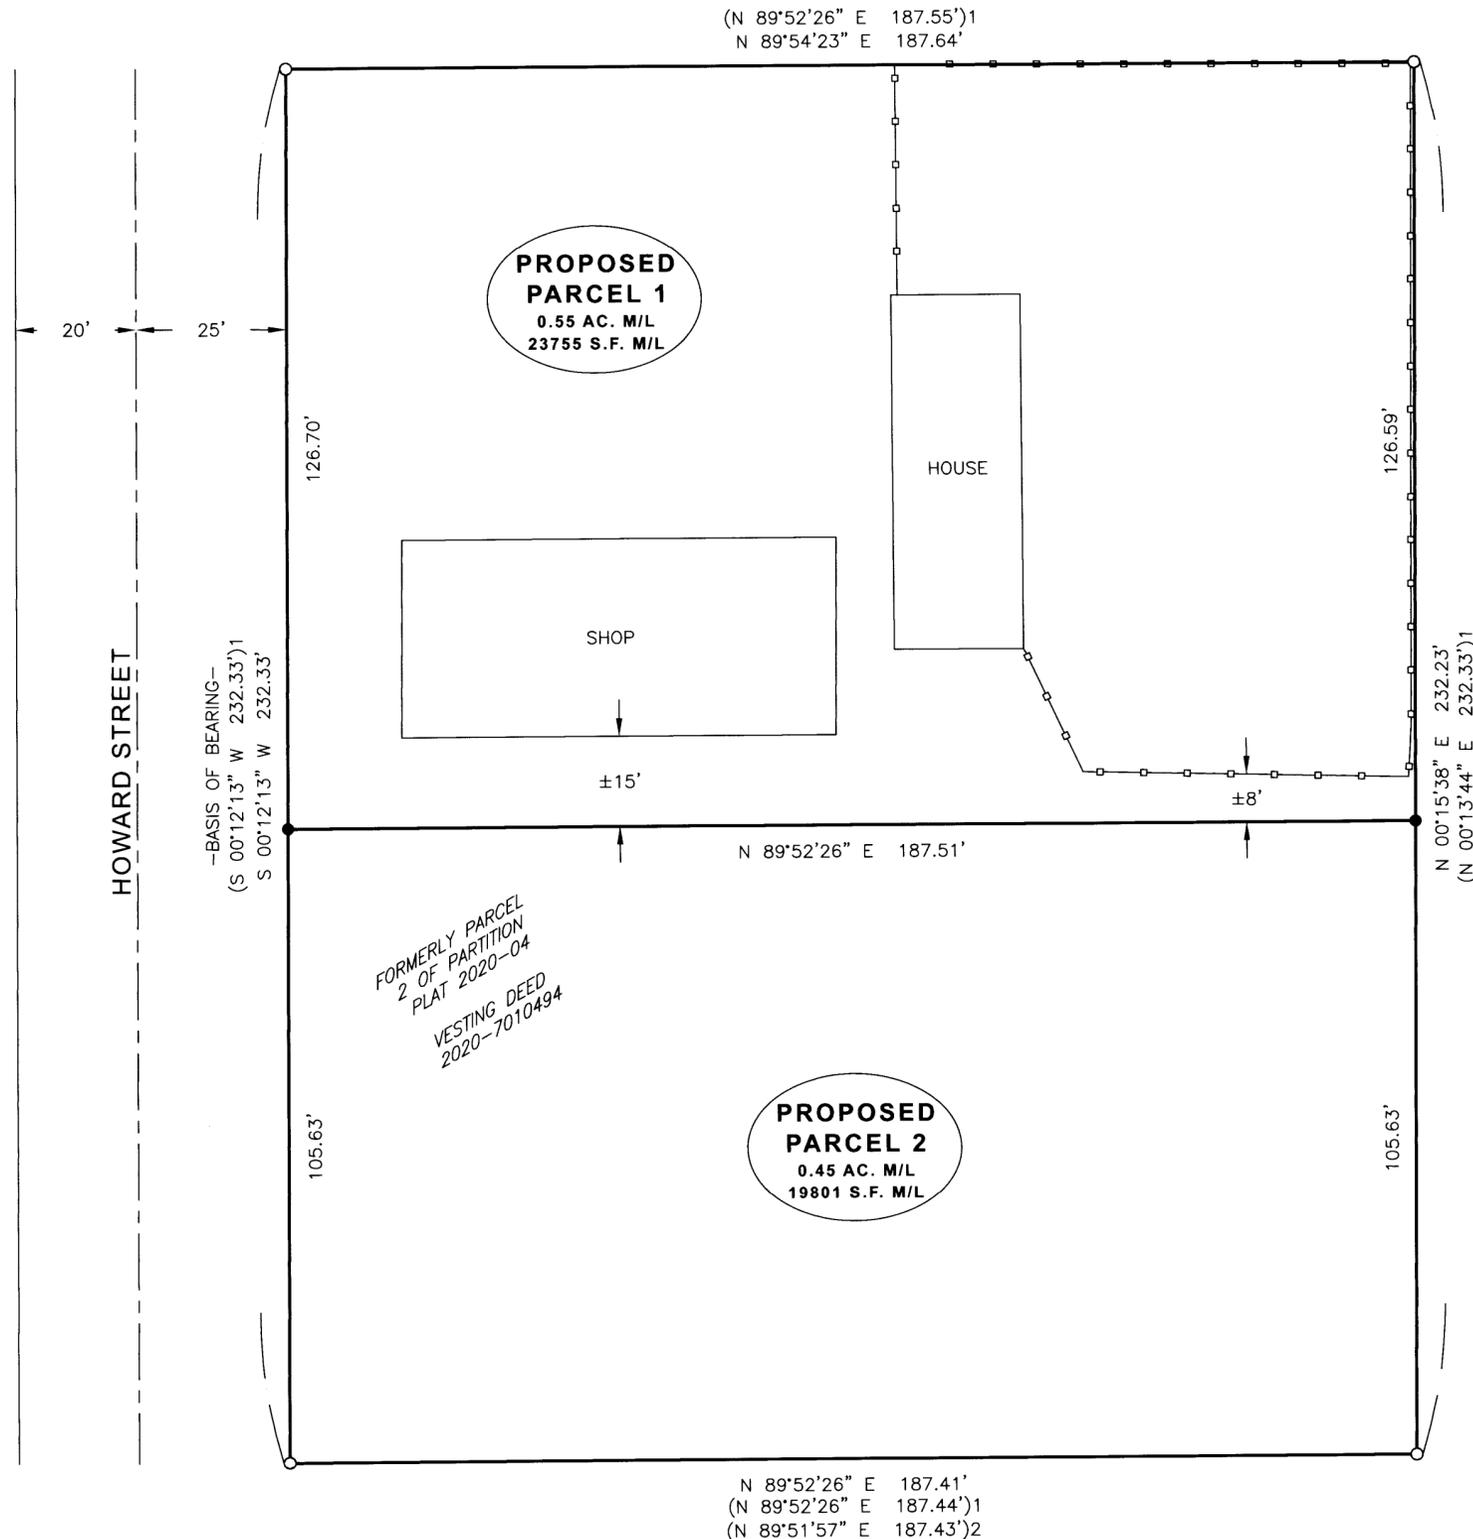


PROPOSED LAND PARTITION  
 LOCATED IN THE NE1\4 SE 1/4  
 OF SECTION 32, T4N, R29E, W.M.  
 CITY OF STANFIELD, UMATILLA COUNTY, OR  
 STANFIELD FILE NO. 66-2024

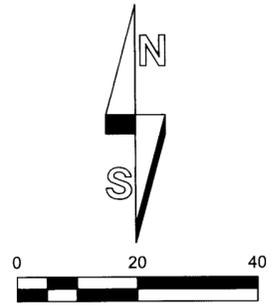

**SURVEY NARRATIVE**

THIS RECORD OF SURVEY IS BEING PREPARED TO DOCUMENT THE LOCATION OF SET BOUNDARY CORNERS AS PART OF AN APPROVED CITY OF STANFIELD LAND PARTITION THAT HAS NOT BEEN RECORDED. PROPOSED PARCELS 1 & 2 AS MAPPED HEREON HAVE NOT BEEN LEGALLY CREATED AT THE TIME OF RECORDING OF THIS SURVEY.

NARRATIVE FROM UNRECORDED PLAT:  
 THIS PLAT HAS BEEN PREPARED AT THE REQUEST OF GARRY & NIC MARCUM. THE PURPOSE IS TO PROVIDE THE REQUIRED SURVEY AND MAPPING FOR APPROVED LAND PARTITION 66-2024, CITY OF STANFIELD. I FOUND AND HELD EXISTING MONUMENTS MARKING THE BOUNDARY OF PARCEL 2 PER PARTITION PLAT 2020-04. THE NEW DIVISION LINE HAS BEEN MAPPED ACCORDING TO INSTRUCTION PROVIDED BY THE CURRENT OWNER, GARRY MARCUM.

THIS SURVEY WAS PERFORMED USING TWO TOPCON HIPER HR GNSS UNITS OPERATED USING RTK METHODS. THE BASIS OF BEARING IS THE WEST LINE OF PARCEL 2 OF PARTITION PLAT 2020-04. DISTANCES ARE GROUND, INTERNATIONAL FEET.

**LEGEND**

- SET 5/8" X 30" STEEL REBAR WITH 1-1/4" PINK PLASTIC CAP, MARKED "KENNY LS 89374"
- FOUND 5/8" REBAR WITH YELLOW PLASTIC CAP PER PARTITION PLAT 2020-04.
- PROPOSED PARCEL BOUNDARY LINES
- - - EXISTING FENCE LINE
- ( ) RECORD SURVEY DATA REFERENCE, SEE TABLE.
- AC. ACRES
- S.F. SQUARE FEET

**RECORDS OF REFERENCE**

- 1: PARTITION PLAT 2020-04.
- 2: PARTITION PLAT 2025-04.

RECEIVED BY  
 Umatilla County Surveyor

Date: 3/10/26  
 Rec'd By: CT  
 No.: 26-014-B

REGISTERED  
 PROFESSIONAL  
 LAND SURVEYOR

*Matthew Patrick Kenny*  
 OREGON  
 JAN 12, 2016  
 MATTHEW PATRICK KENNY  
 89374PLS  
 RENEWS: 6-30-27

	P.O. BOX 447, HEPPNER, OR 97836 541-379-0242 www.kennylandsurveying.com		
	PROPOSED LAND PARTITION OF PARCEL 2, PARTITION PLAT 2020-04 CITY OF STANFIELD, UMATILLA COUNTY, OR		
CLIENT:	NIC MARCUM		
PROJECT: 2410	DR: MPK	SC: 1"=20'	DATE: JULY 31, 2025
		SHEET 1 OF 1	