


CERTIFIED RECORD OF LAND CORNER MONUMENTATION

History of original corner establishment:

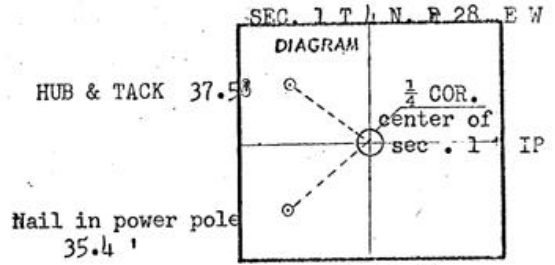

C-23

Description of corner evidence found:

Found 1" iron pipe as noted in field notes of Verl Fraley when a survey was made in 1950.

Description of monument and accessories I established to perpetuate the original location of this corner

I referenced the corner by swing ties to a power pole 35.4 ft. southwesterly of the cor. and also set a hub and tack 37.5 ft. north westerly of the cor.

Office of COCONY SURVEYOR County of UMATILLA
 State of OREGON, I hereby certify that the within instrument was filed in this office
 for record on the 6 day of MARCH, 1970, at o'clock m., (signed)
Ralph Thompson by
 (COUNTY OFFICIAL) (DEPUTY)