


Umatilla County Depot Plan District - Zoning

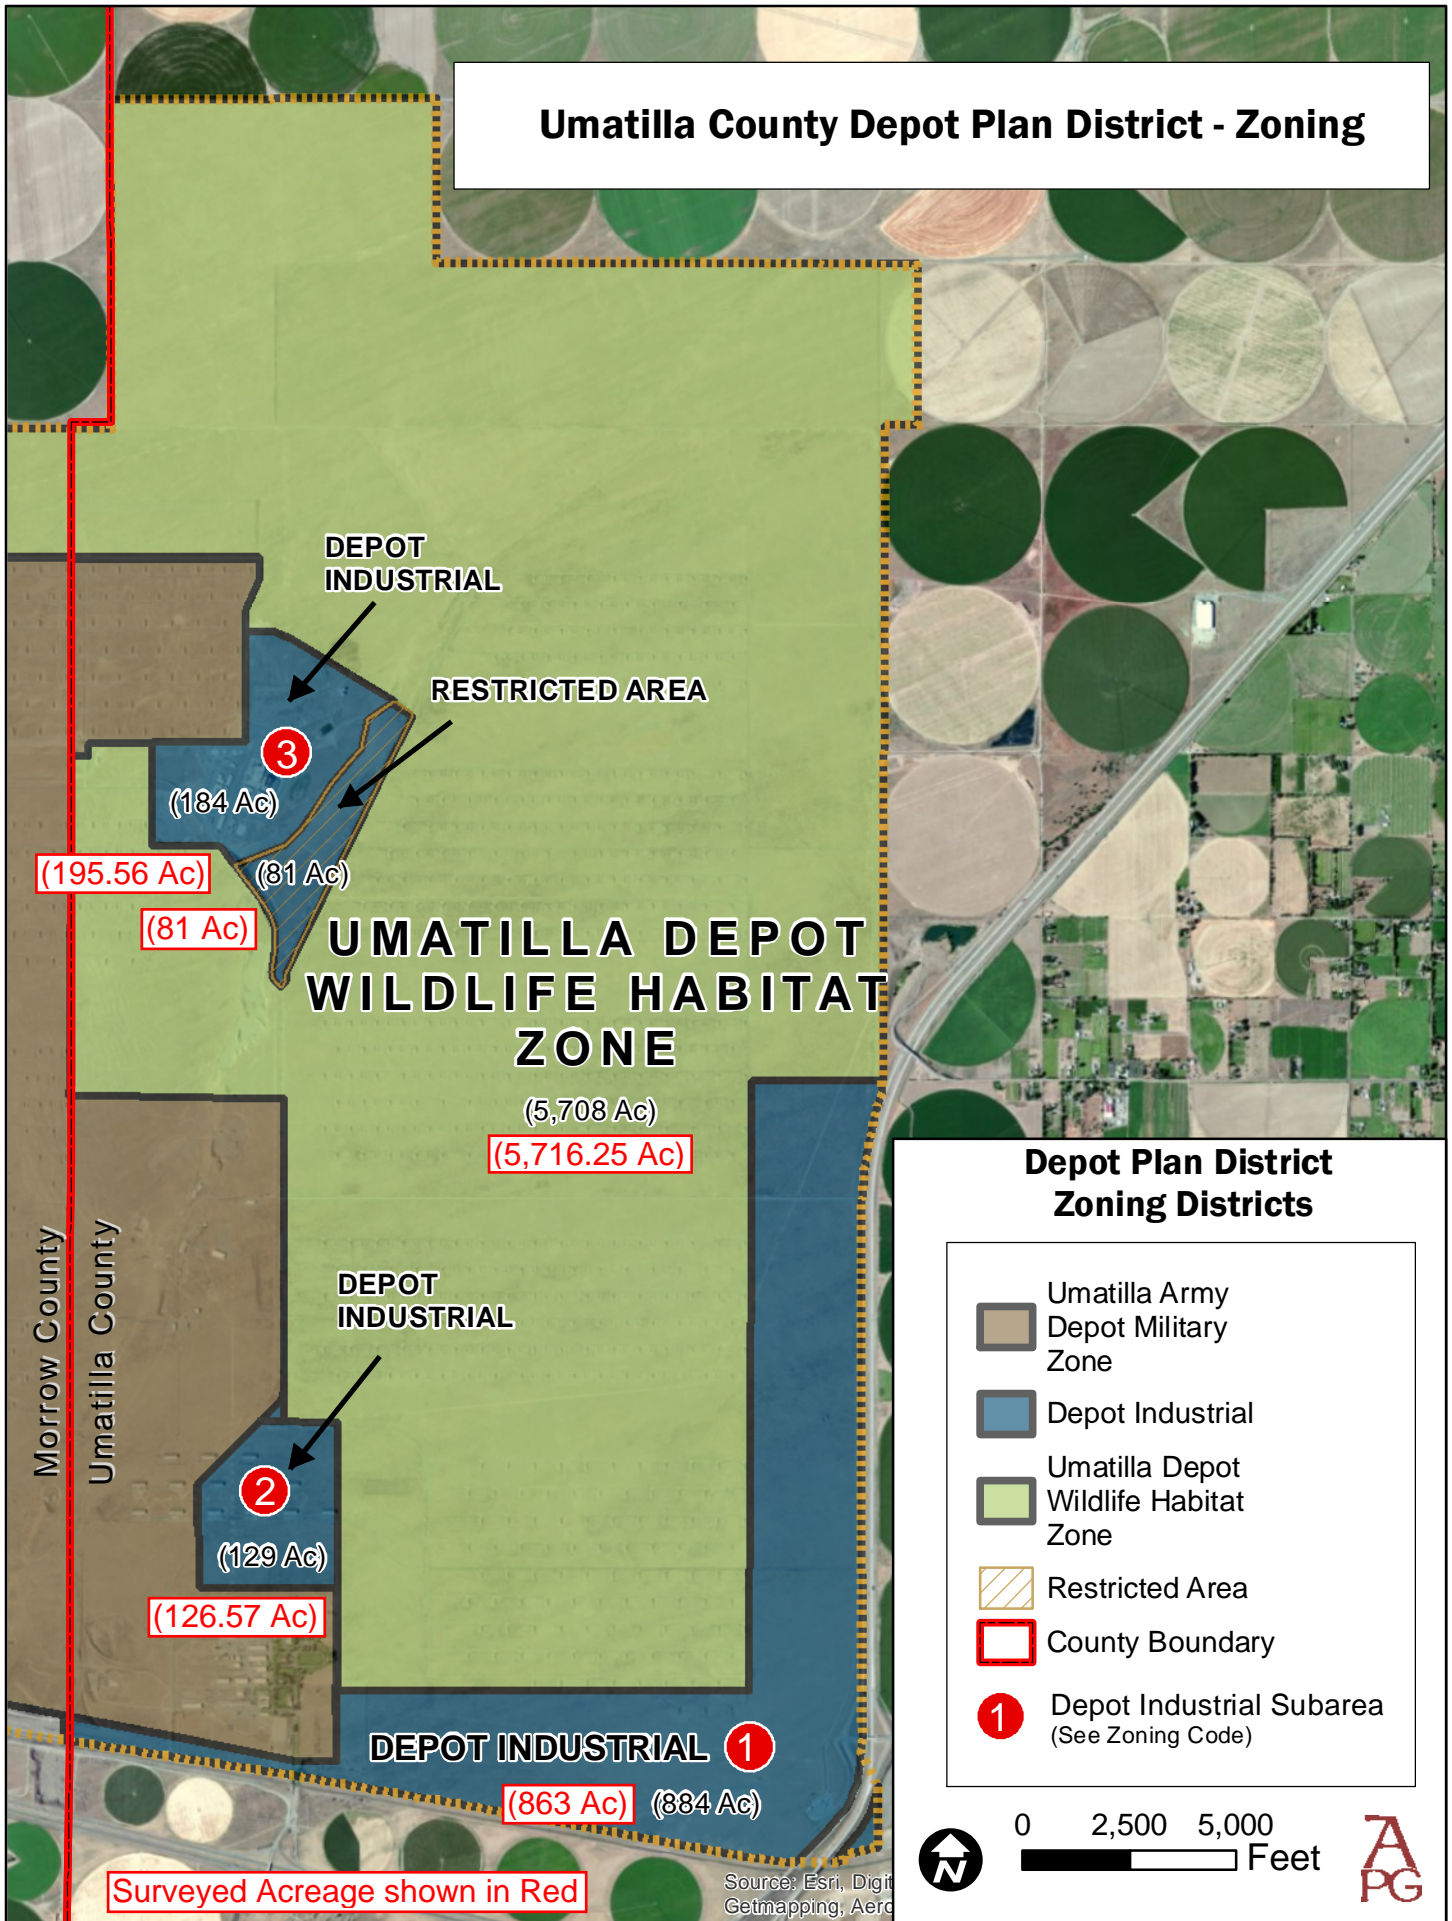

Depot Plan District Zoning Districts

- Umatilla Army Depot Military Zone
- Depot Industrial
- Umatilla Depot Wildlife Habitat Zone
- Restricted Area
- County Boundary
- Depot Industrial Subarea (See Zoning Code)



0 2,500 5,000 Feet



Surveyed Acreage shown in Red

Source: Esri, Digit
Getmapping, Aer