


MAP OF
TOWNSHIP 4 N., RANGE 29 E.
 OF THE WILLAMETTE MERIDIAN

Scale 2 inches to 1 mile

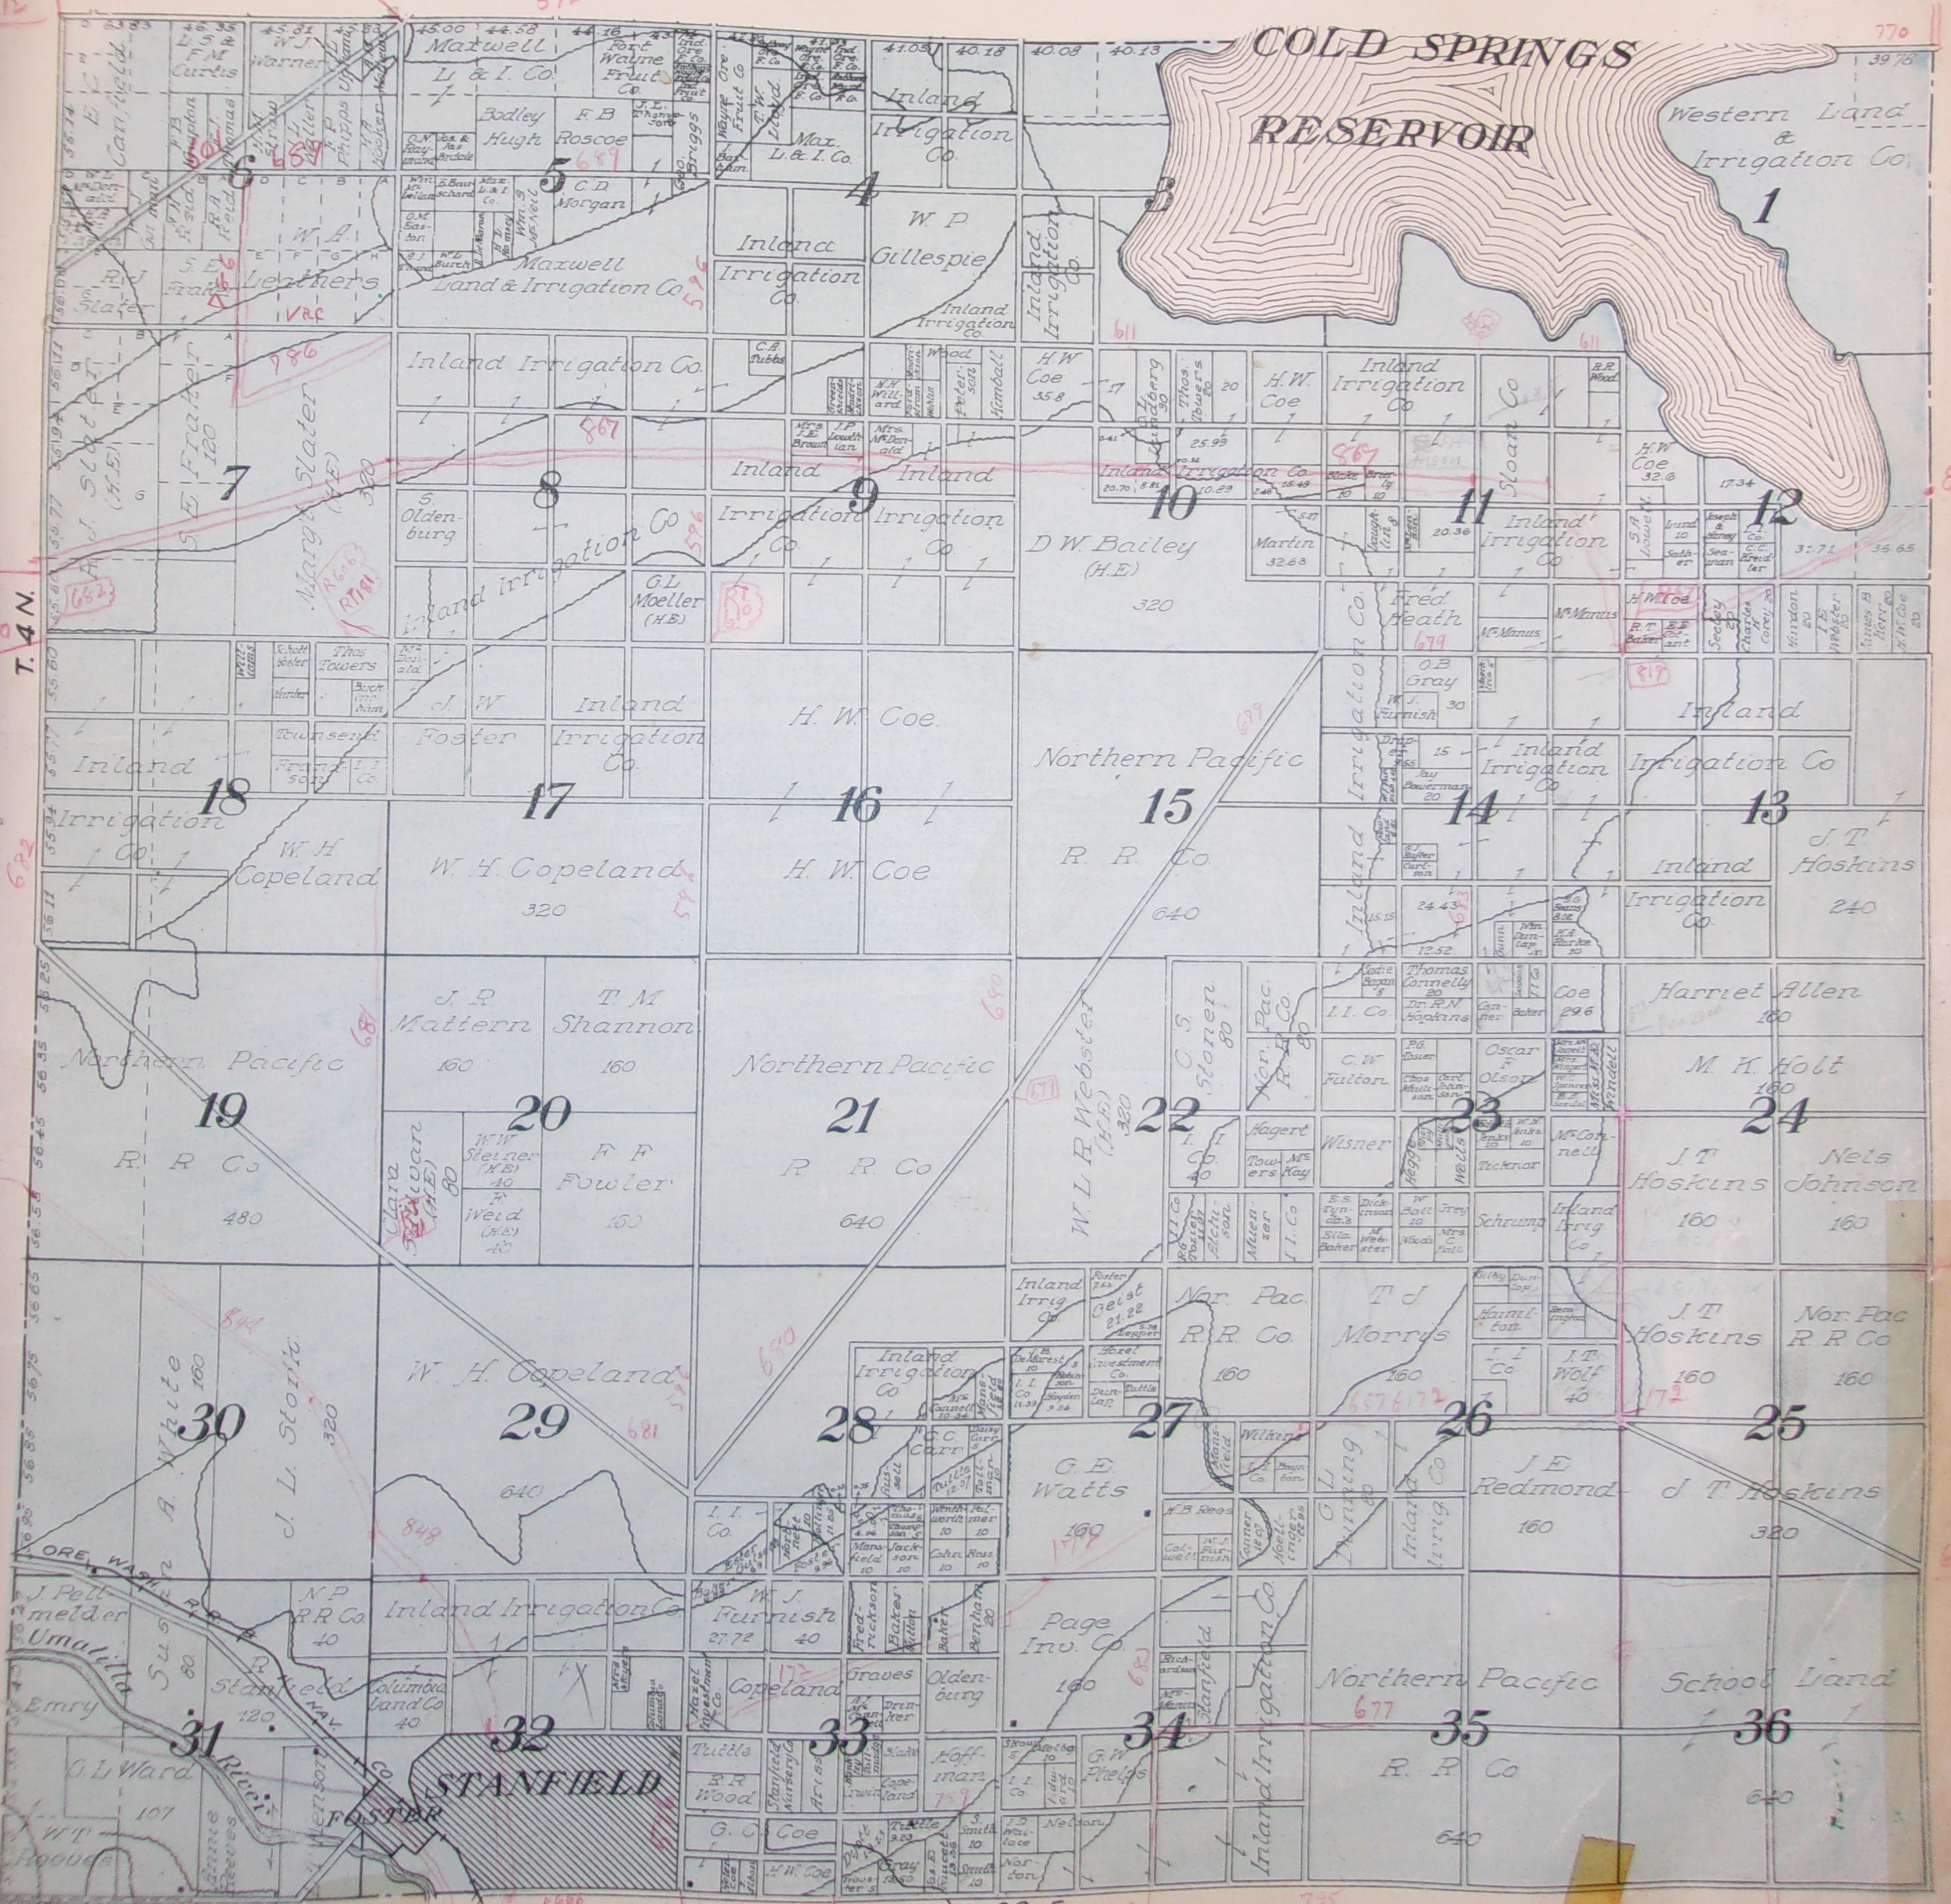

T. 4 N.

R. 29 E.