

8-20-56

NZ-6P-13

21 22
28 27

16 15
21 22

103250
49925


22 23
27 26

18 17
23 23

6 N 36

15
22

6 N 36

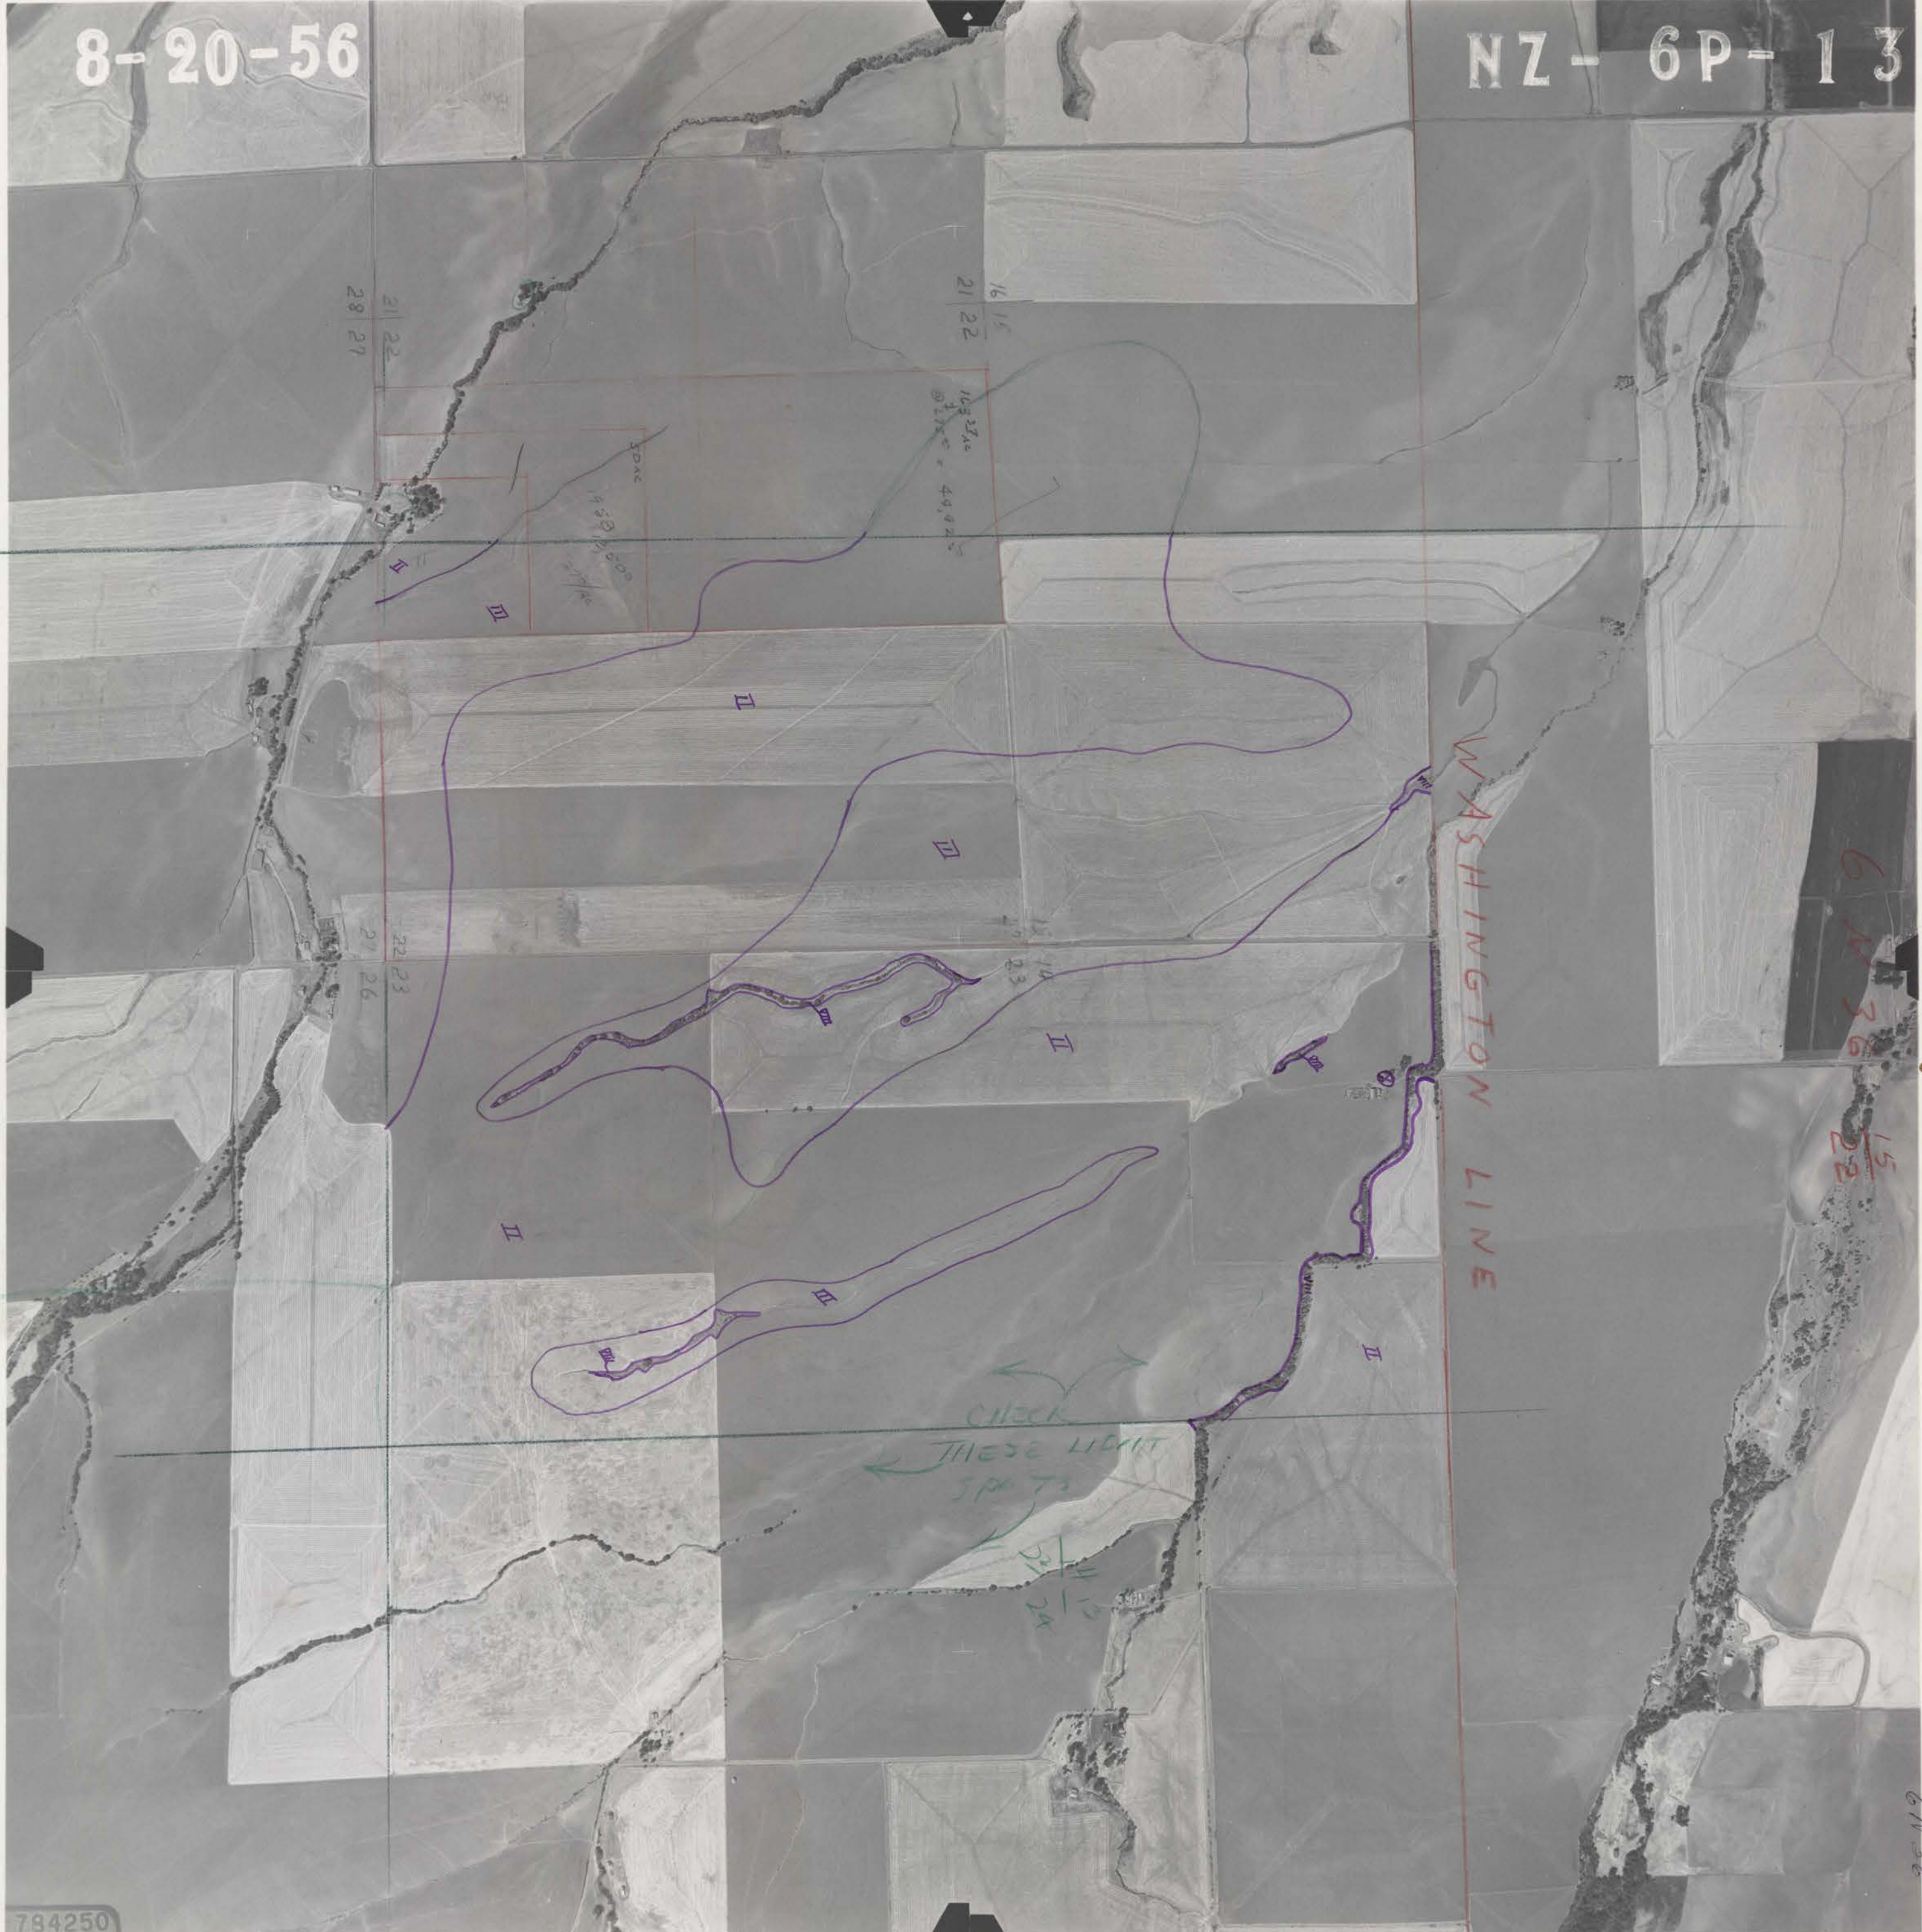

WASHINGTON LINE

CHECK
THESE LIGHT
SPOTS

11 10
27 24

784250