


10-1-56 12:32 CSS-1:20,000 NZ-8P-61

25 31

Effective area overlaps photo 8P-60

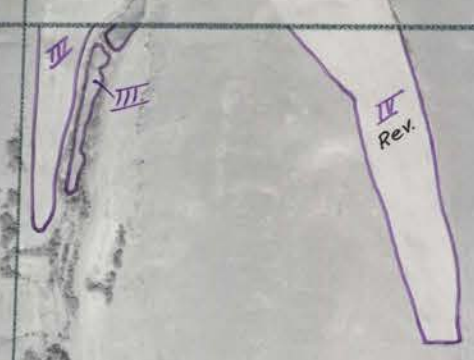

VII



Rev.

Rev.

VII

Rev.

