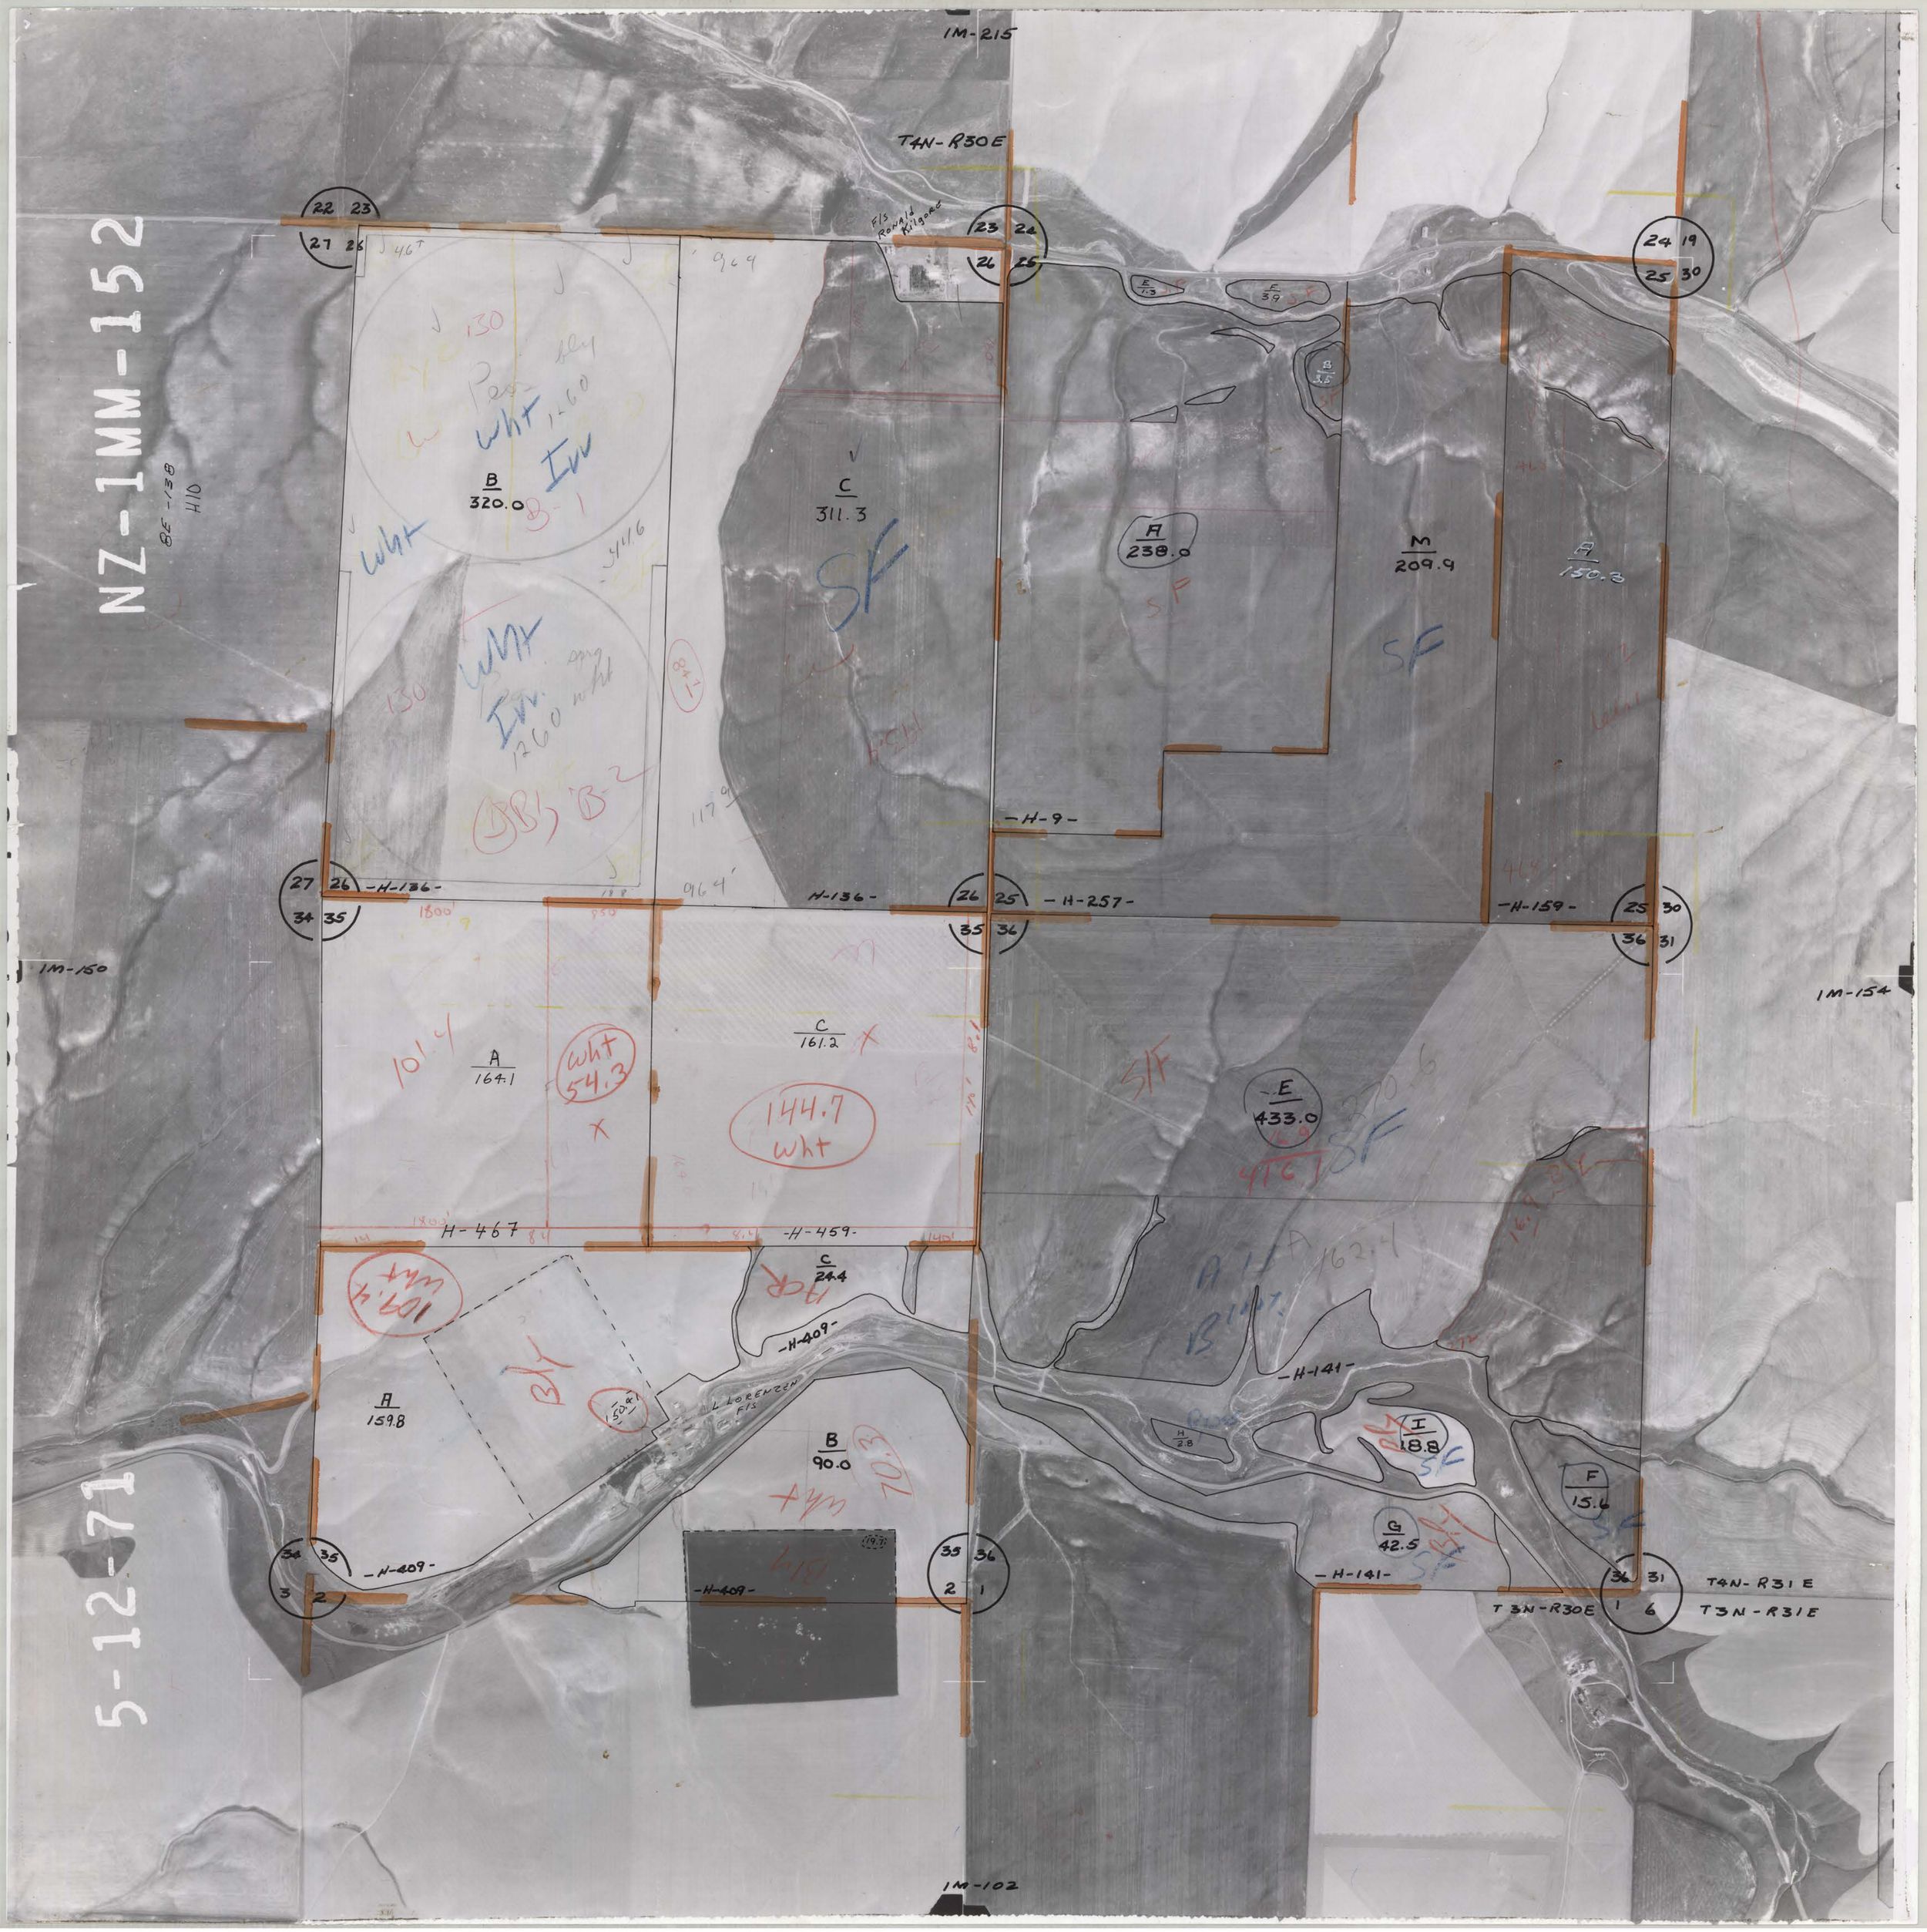

NZ-1MM-152
5-12-71
1M-215
T4N-R30E
F/S Ronald Kilgore
22 23
27 26
23 24
26 25
24 19
25 30
B
320.0
C
311.3
A
238.0
M
209.9
A
150.3
-H-9-
27 26
34 35
-H-136-
H-136-
26 25
35 36
-H-257-
-H-159-
25 30
36 31
1M-150
1M-154
A
164.1
C
161.2
E
433.0
H-467
-H-459-
C
24.4
-H-409-
A
159.8
B
90.0
-H-141-
I
18.8
F
15.6
G
42.5
-H-409-
-H-409-
-H-141-
T4N-R31E
T3N-R30E
T3N-R31E
1M-102