

53 L I'

T1N-R31E

13 Q -2


P 12

T 1870




JOHNSON WEST

JOHNSON EAST

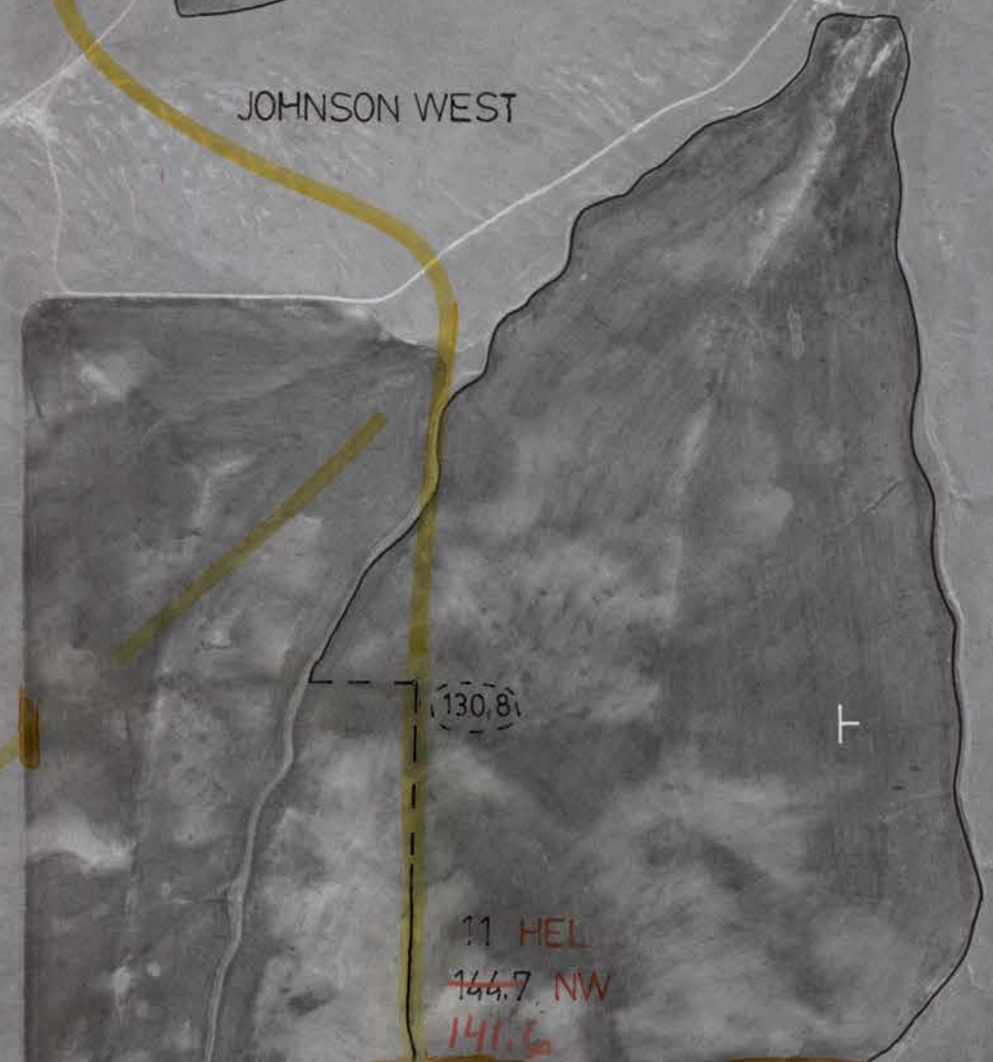

T 1848

T 791

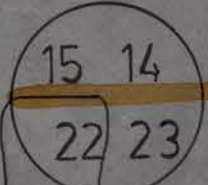

T 1848

1 HEL 49.5 NW 18.0

FRUITT PLACE

(37.5)

202.00

1 HEL 212.3 NW CRP 87-07 61.0

(151.3)

136.76
4 HEL 140.0 NW CRP 87-07

5 HEL 105.29
109.2 NW CRP 87-07

