

53 R I'

SEE MAP
14 P



T1N-R31E

14 Q-2

P 13




T 1870

T2286

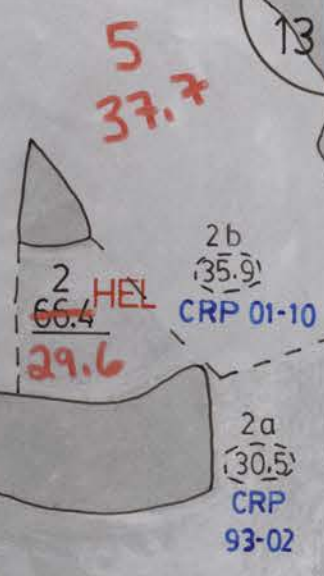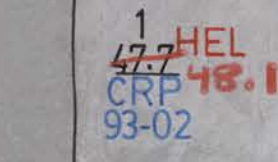

JOHNSON EAST

T940

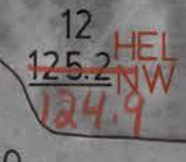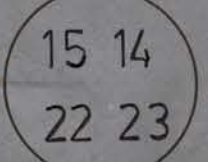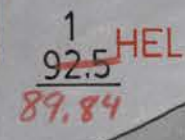

T1870

