

☉ NAPP-7034

14L

16FF

D.D. 15

35 36
2 1

T4S-R32E 36 31 T4S-R33E
T5S-R32E 1 6 T5S-R33E

T10949

T872


2 1
11 12

1 6
12 7

T9668

11 12
14 13

12 7
13 18

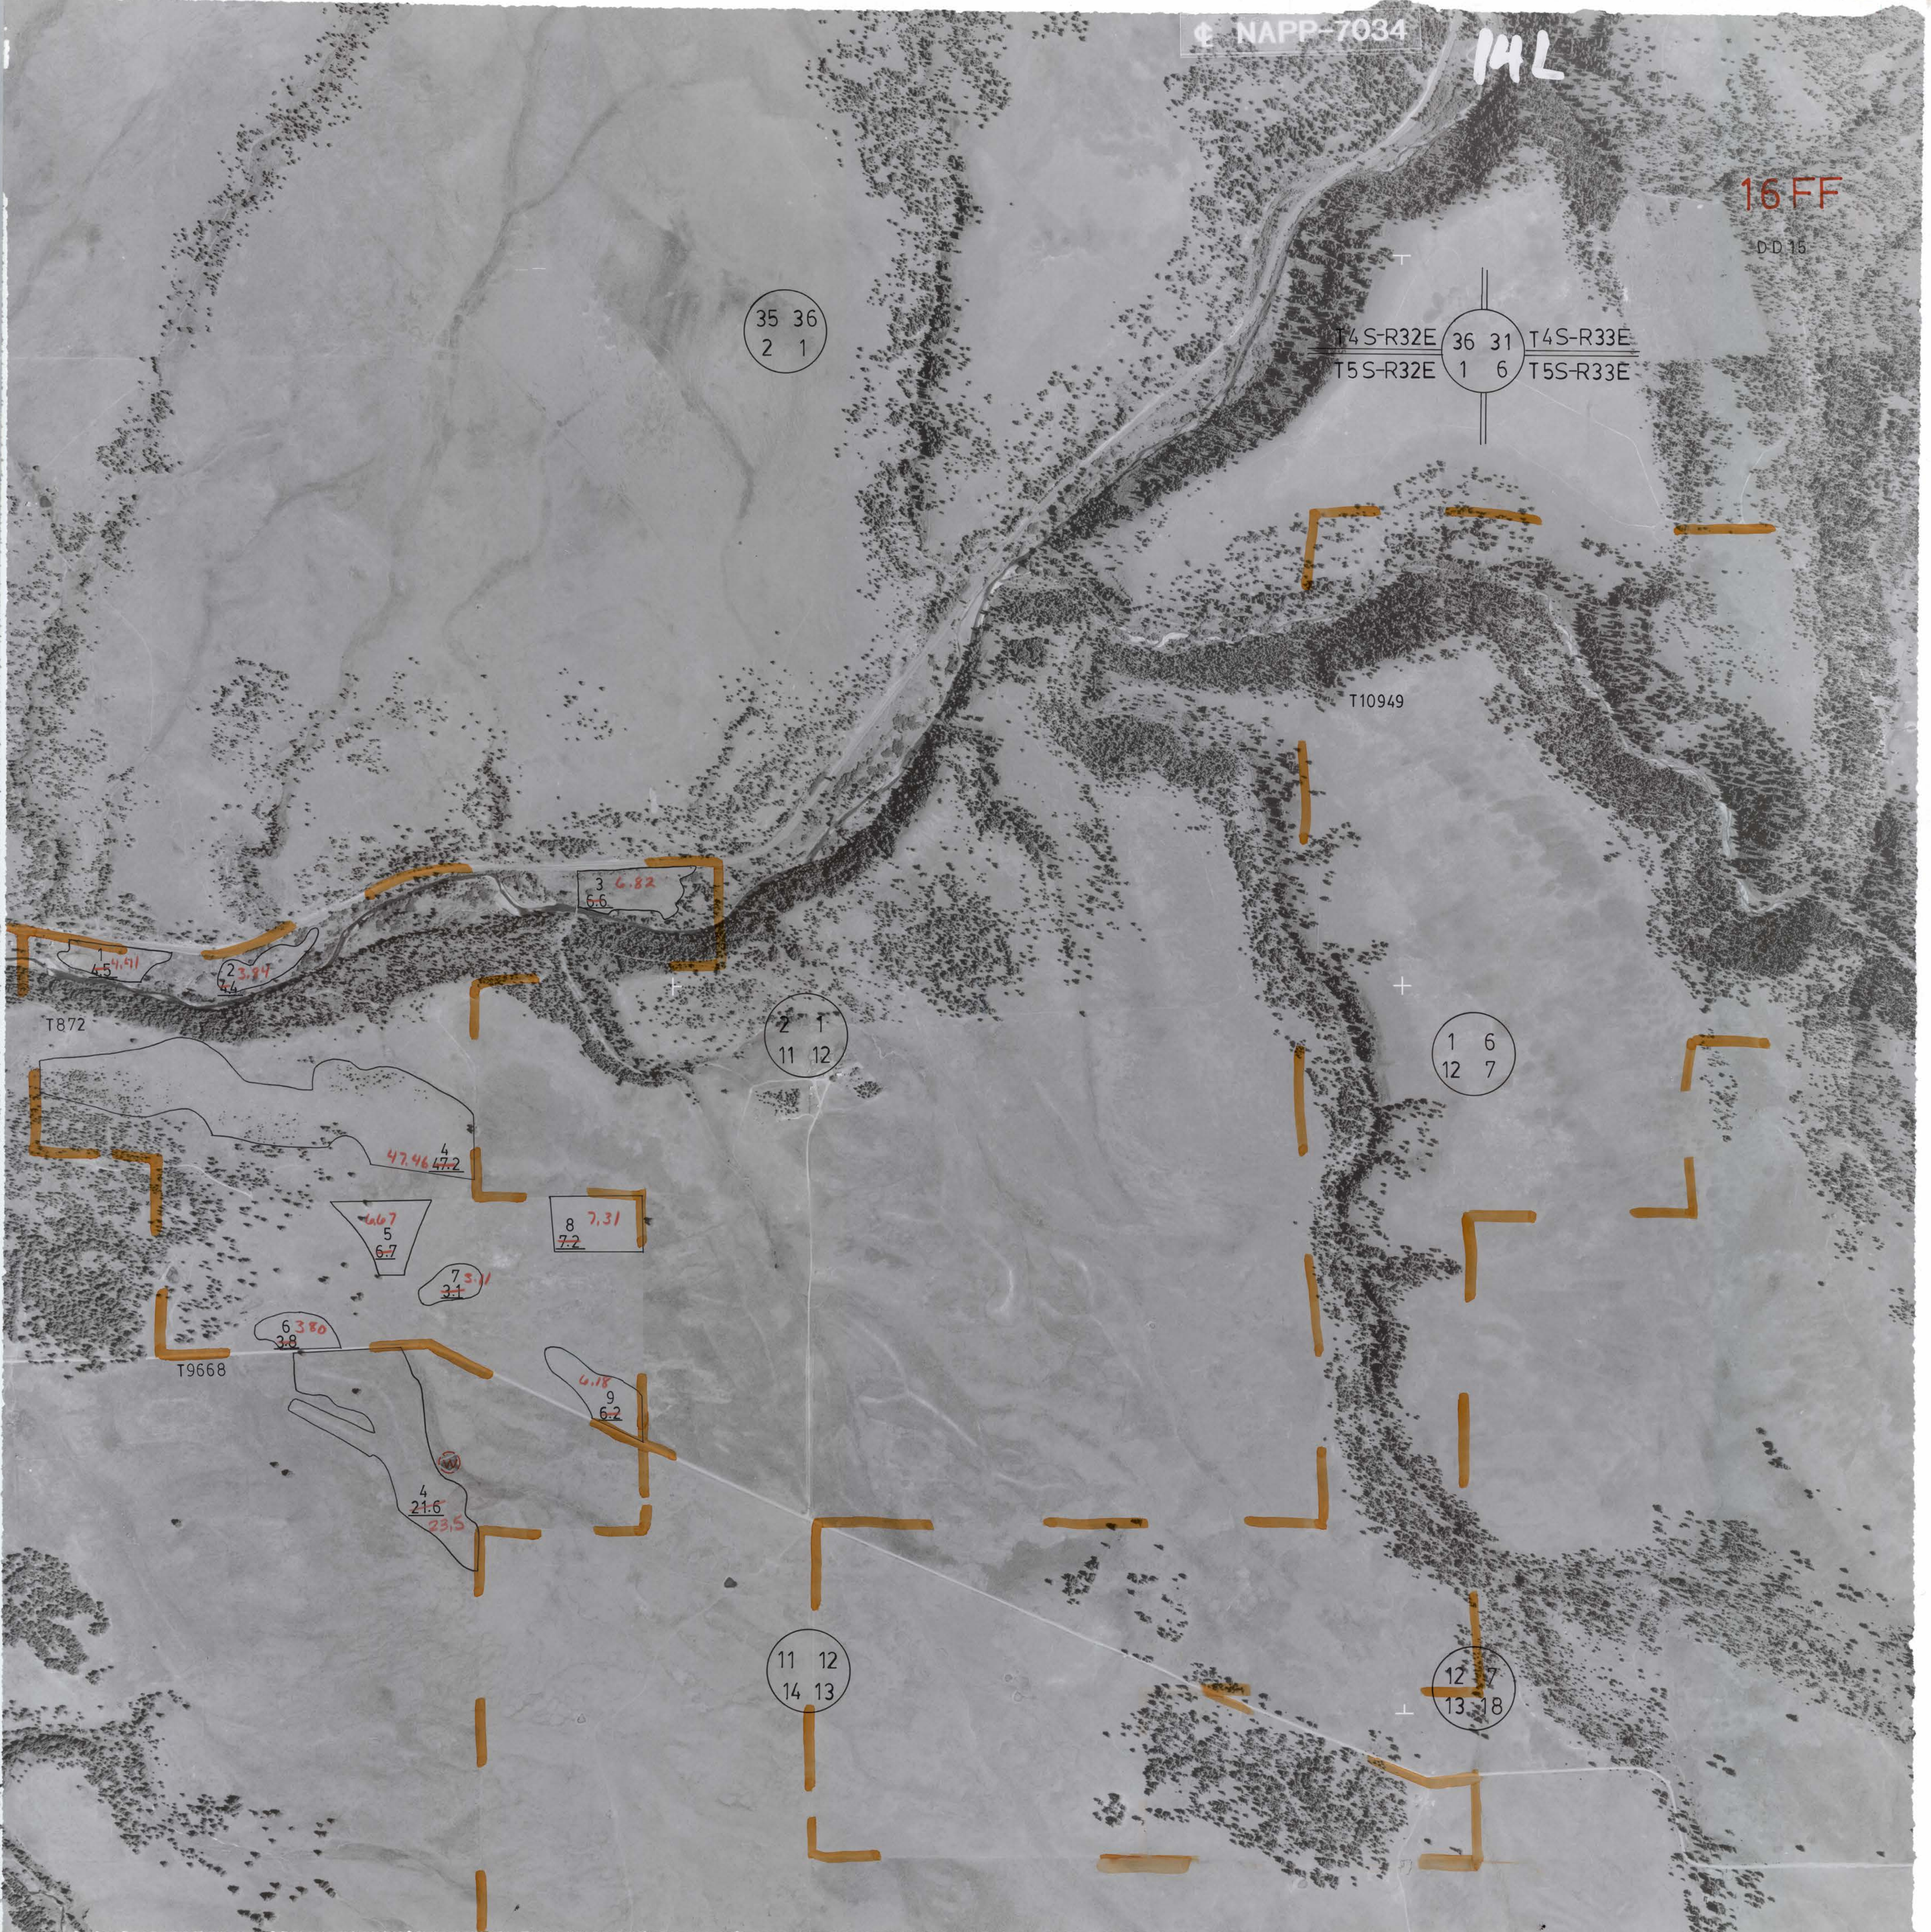

45
4.491

23.84
4.4

3
6.82
6.6

4
47.46
47.2

4
6.7
5
6.7

7
7.51
3.1

8
7.31
7.2

6380
3.8

6.18
9
6.2

4
21.6
23.5