


76 L Hi

16L-1

K-14

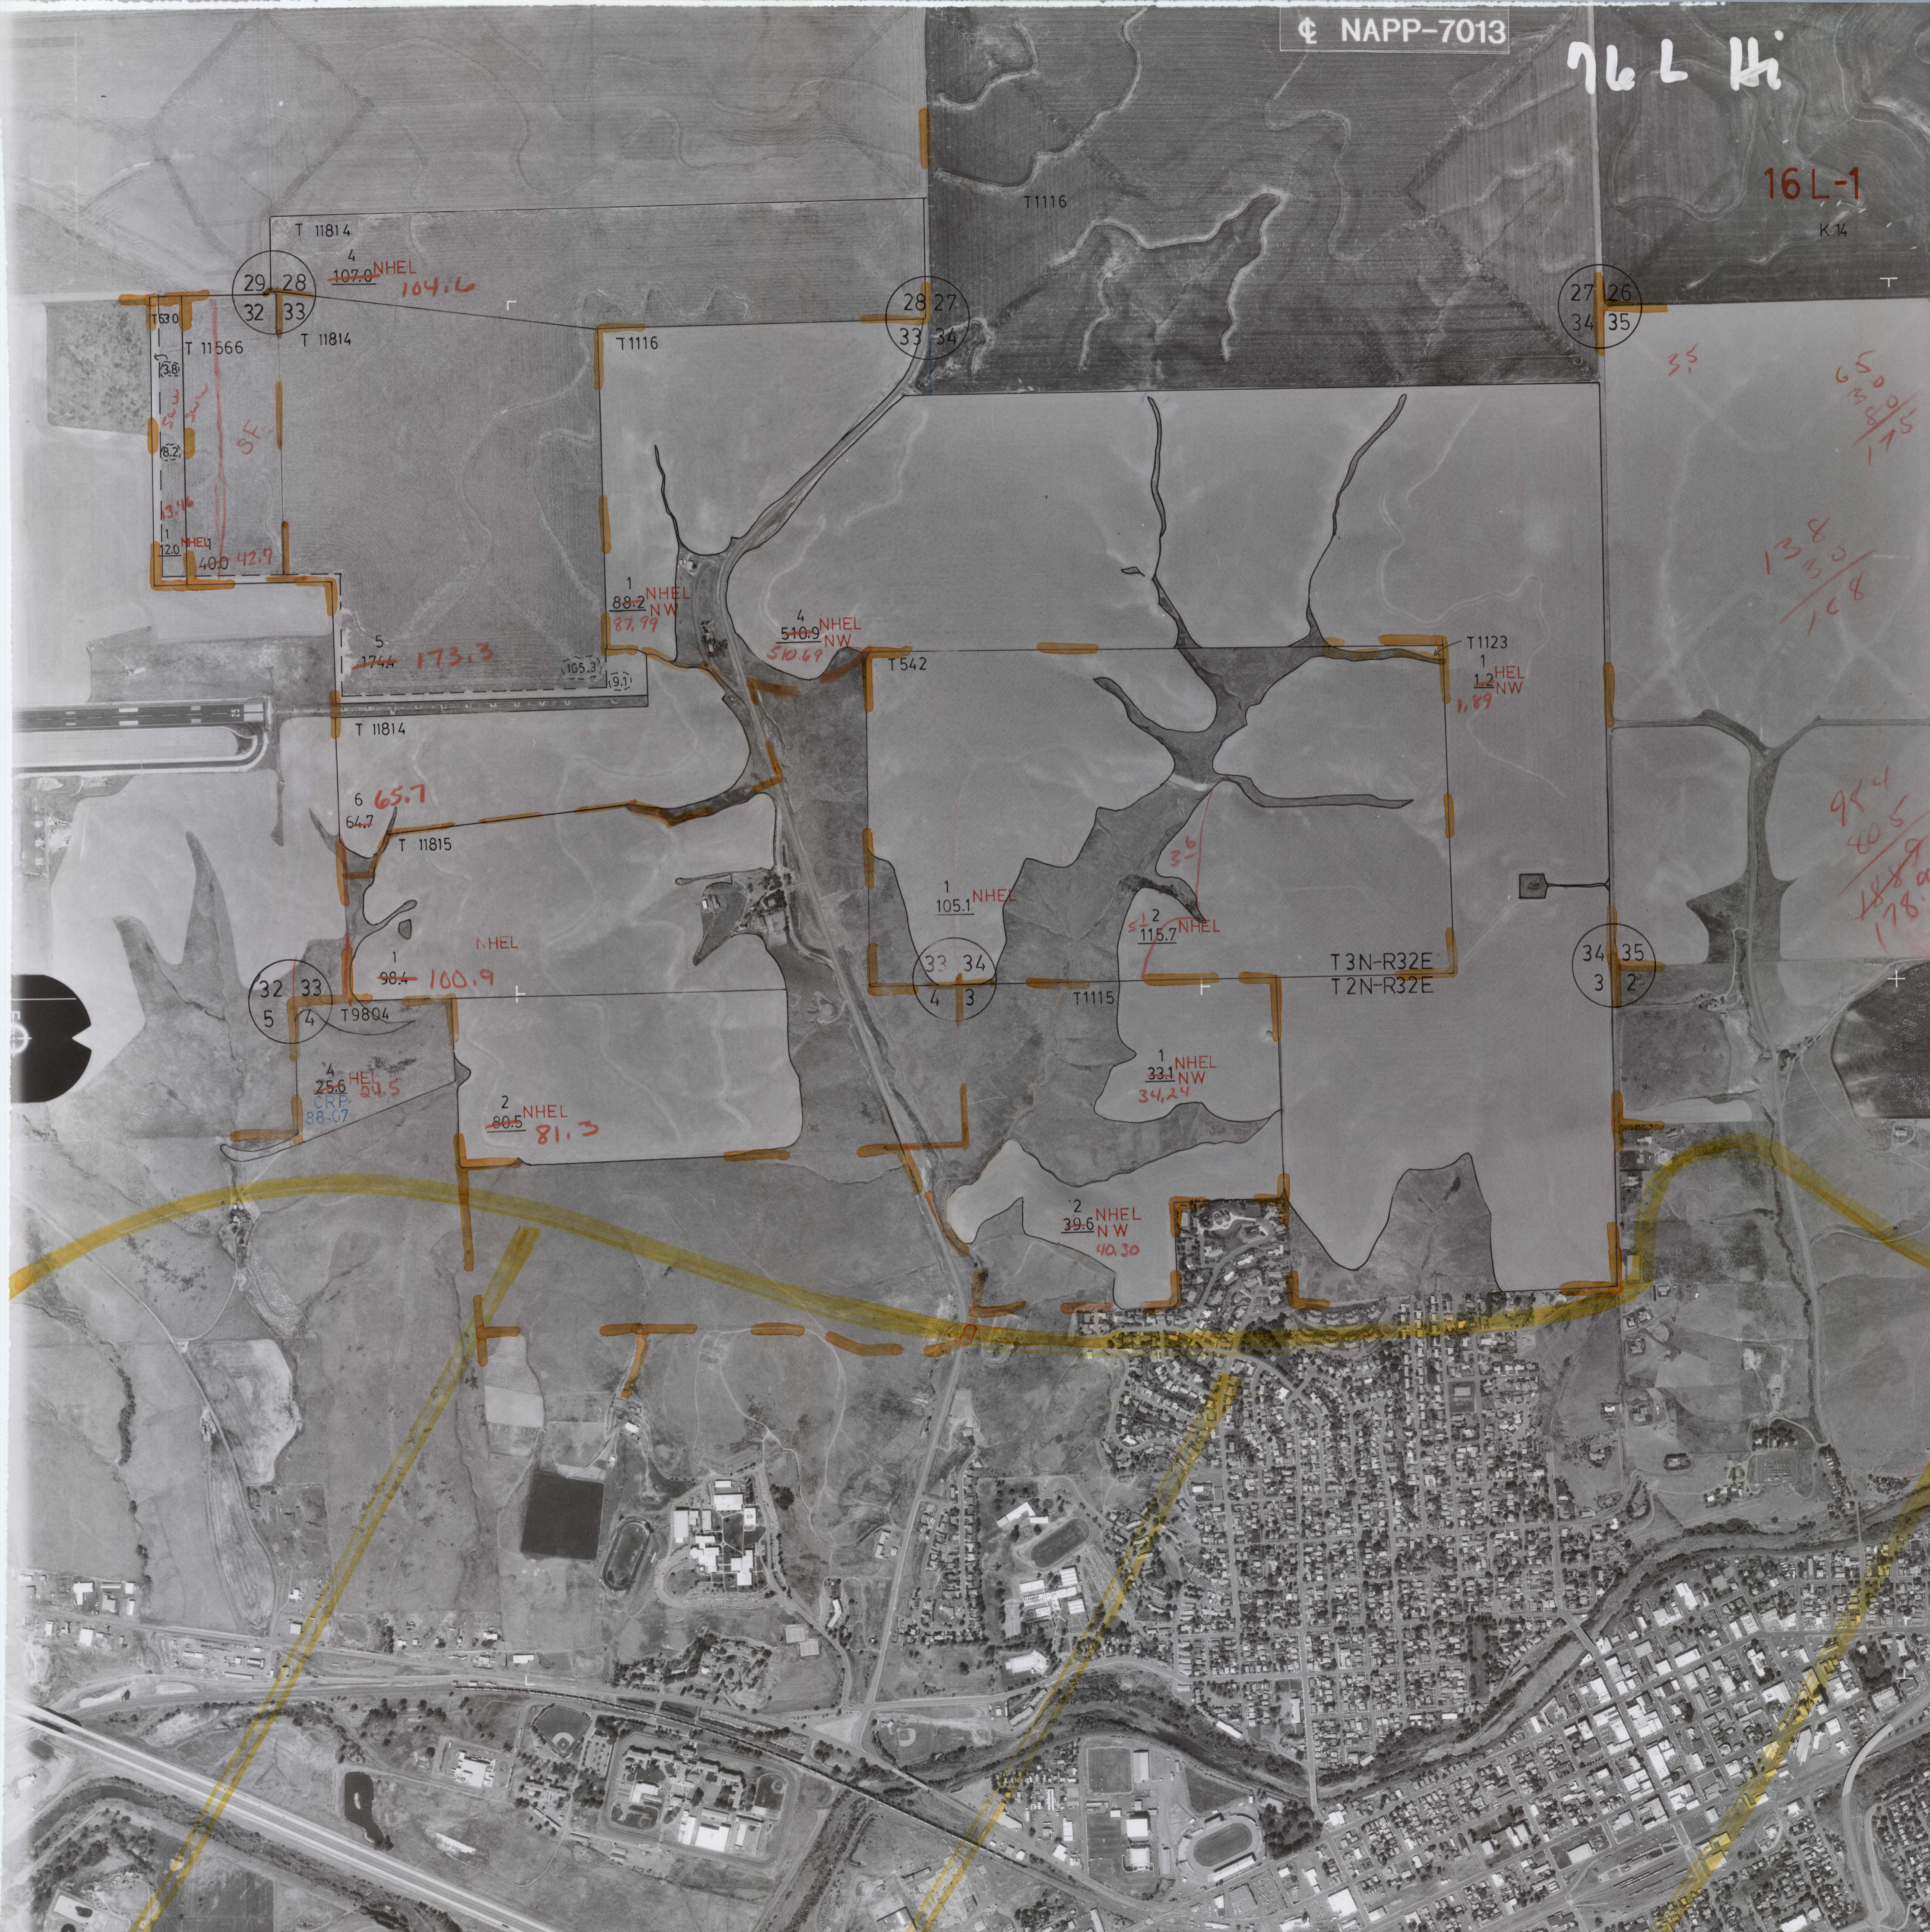

35





T 11814

4 NHEL 107.0

29 28

32 33

104.6

28 27

33 34

27 26

34 35

5 174.4 173.3

1 NHEL 88.2 NW 87.99

4 NHEL 510.9 NW 510.69

T 1123

1 HEL 1.89 NW

6 65.7 64.7

1 NHEL 105.1

33 34

4 3

2 NHEL 115.7

1 NHEL 98.4 100.9

32 33

5 4

T 9804

4 HEL 25.6 CRP 88.07 54.5

2 NHEL 80.5 81.3

1 NHEL 33.1 NW 34.24

2 NHEL 39.6 NW 40.30

34 35

3 2