


249 L 6

25 C-3

C 22

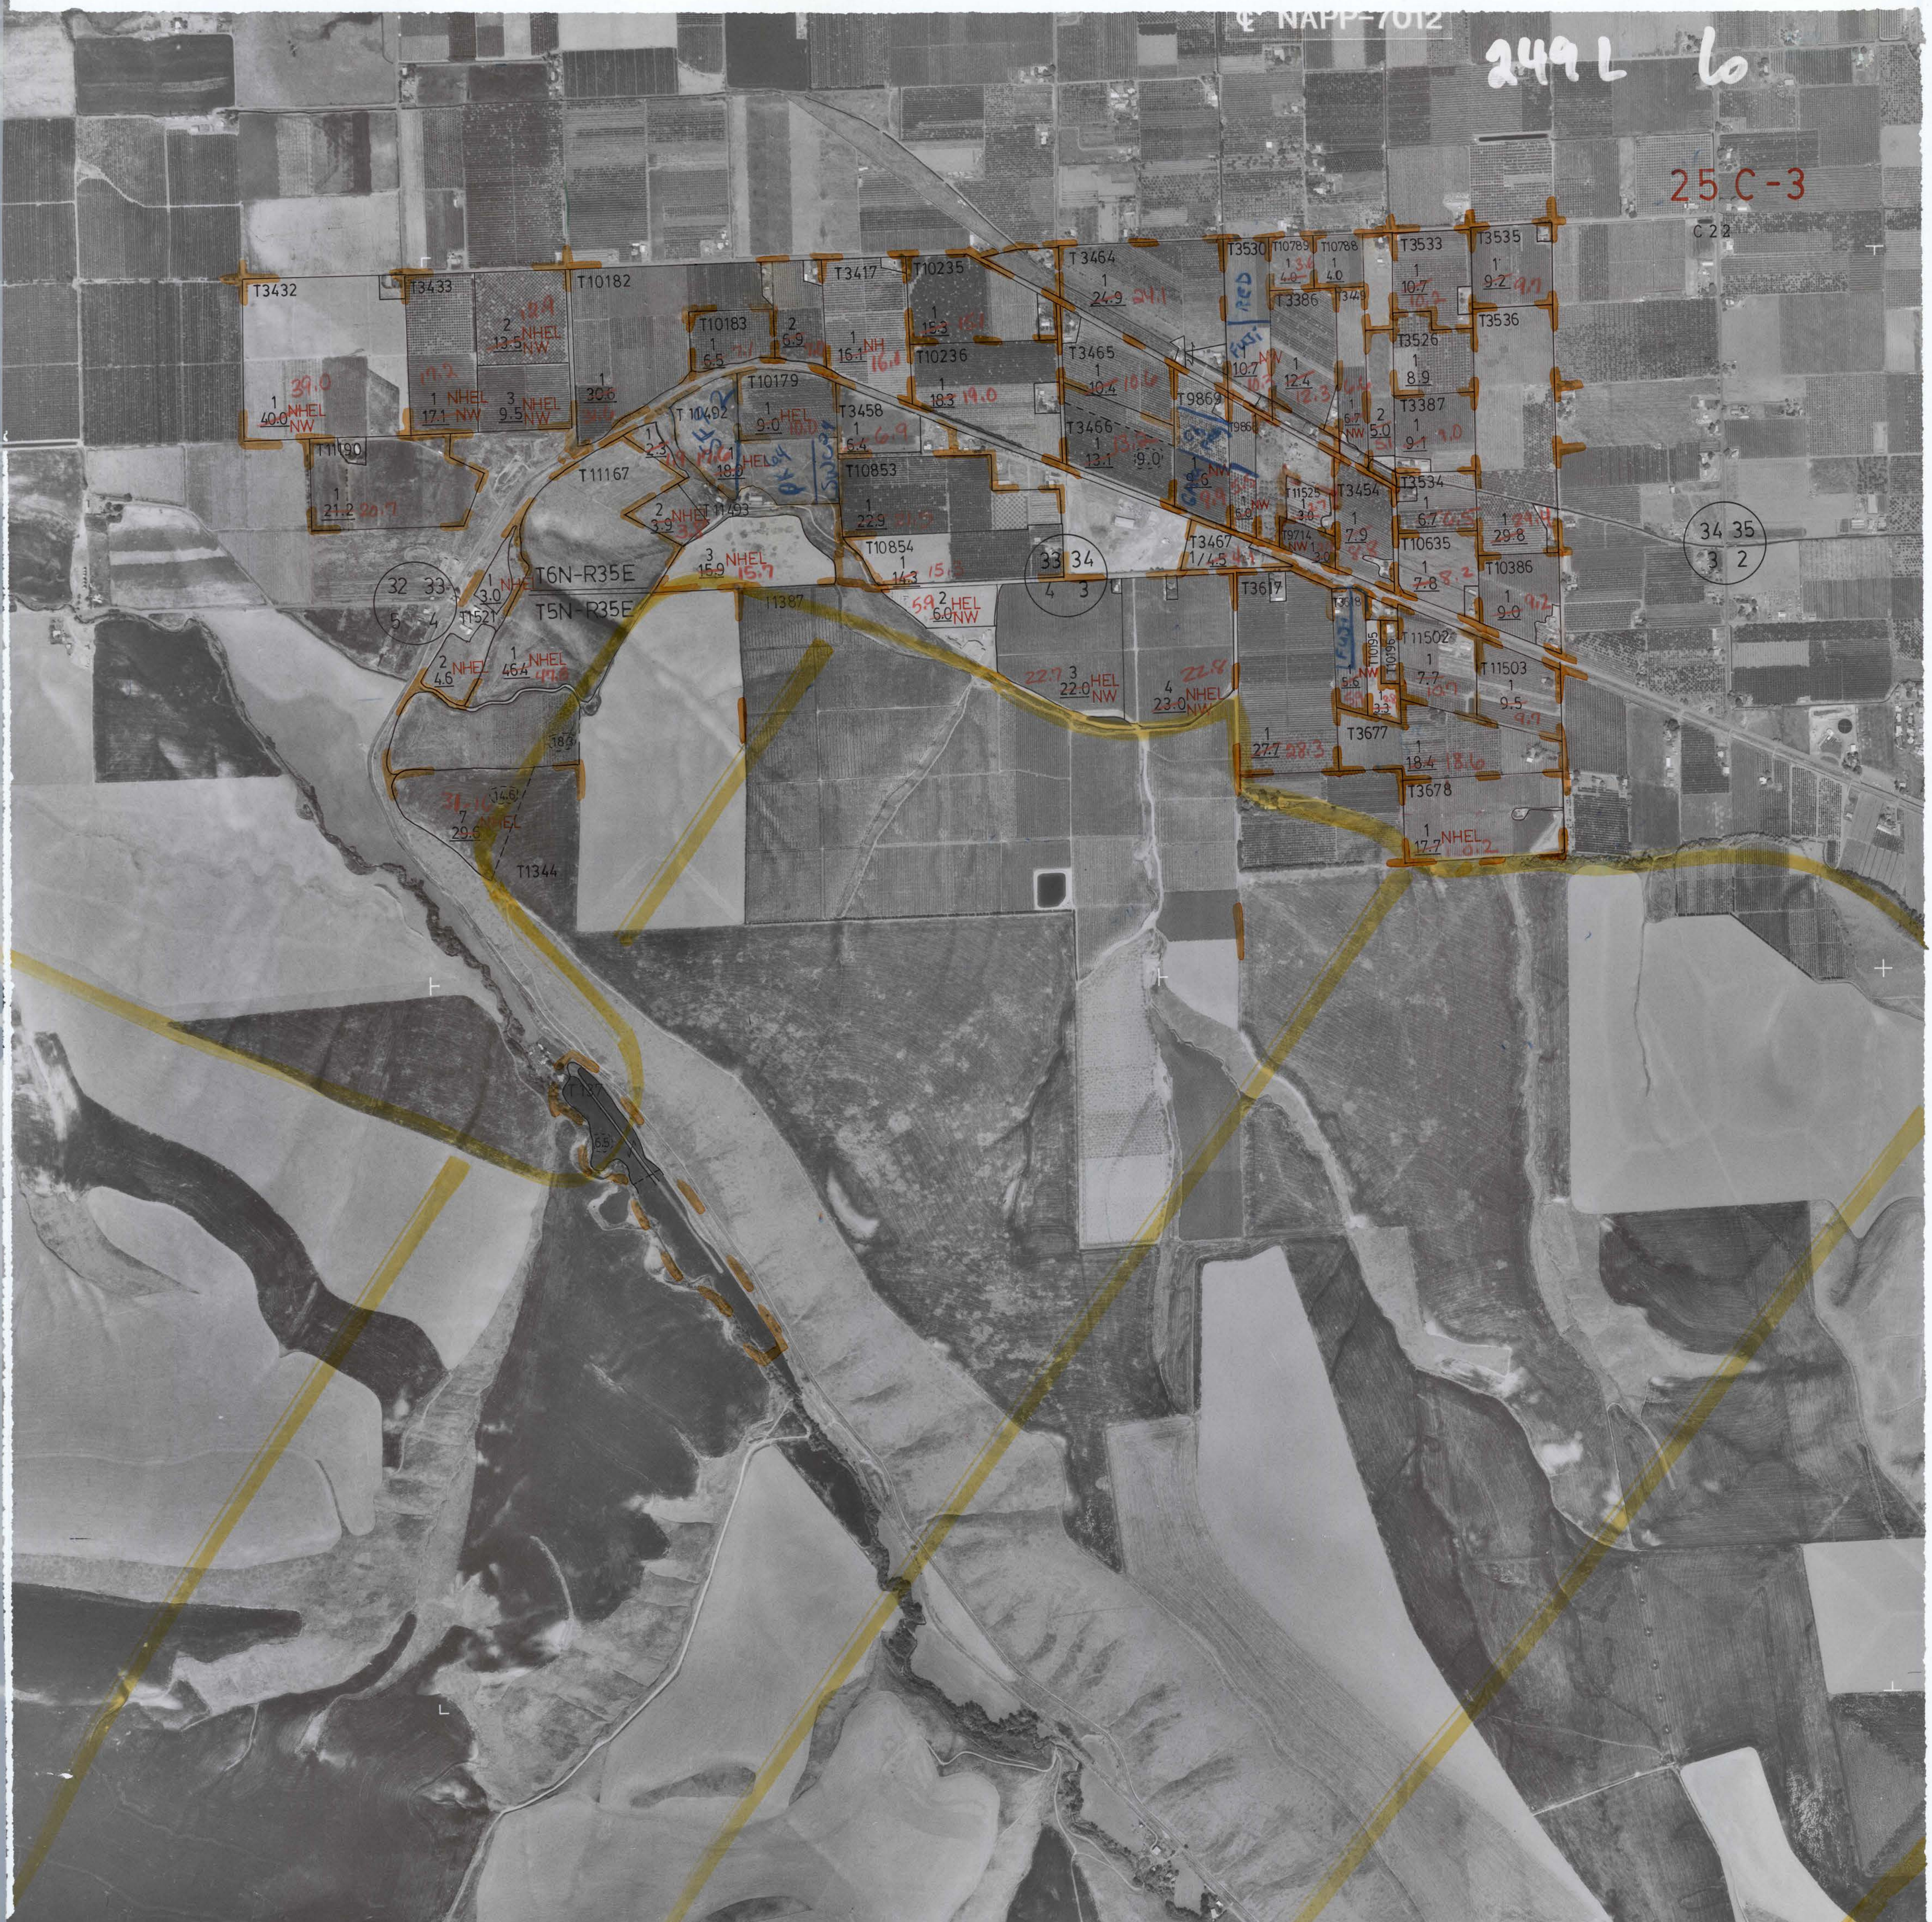

T3432

T3433

T10182

T3417

T10235

T3464

T3530

T10789

T10788

T3533

T3535

T10183

T10179

T10492

T3458

T10236

T3465

T3466

T9869

T3386

T3449

T3526

T3536

T1190

T11167

T10493

T10853

T10854

T10854

T3467

T11525

T3454

T3534

T110635

T10386

























