

SEE MAP
28C-2

28 D-2

D 25

T5N-R36E

T1347

2
(313)


3 NHEL
101.9
105.89

8 9
17 16

15 14
22 23

16 15
21 22

17 16
20 21

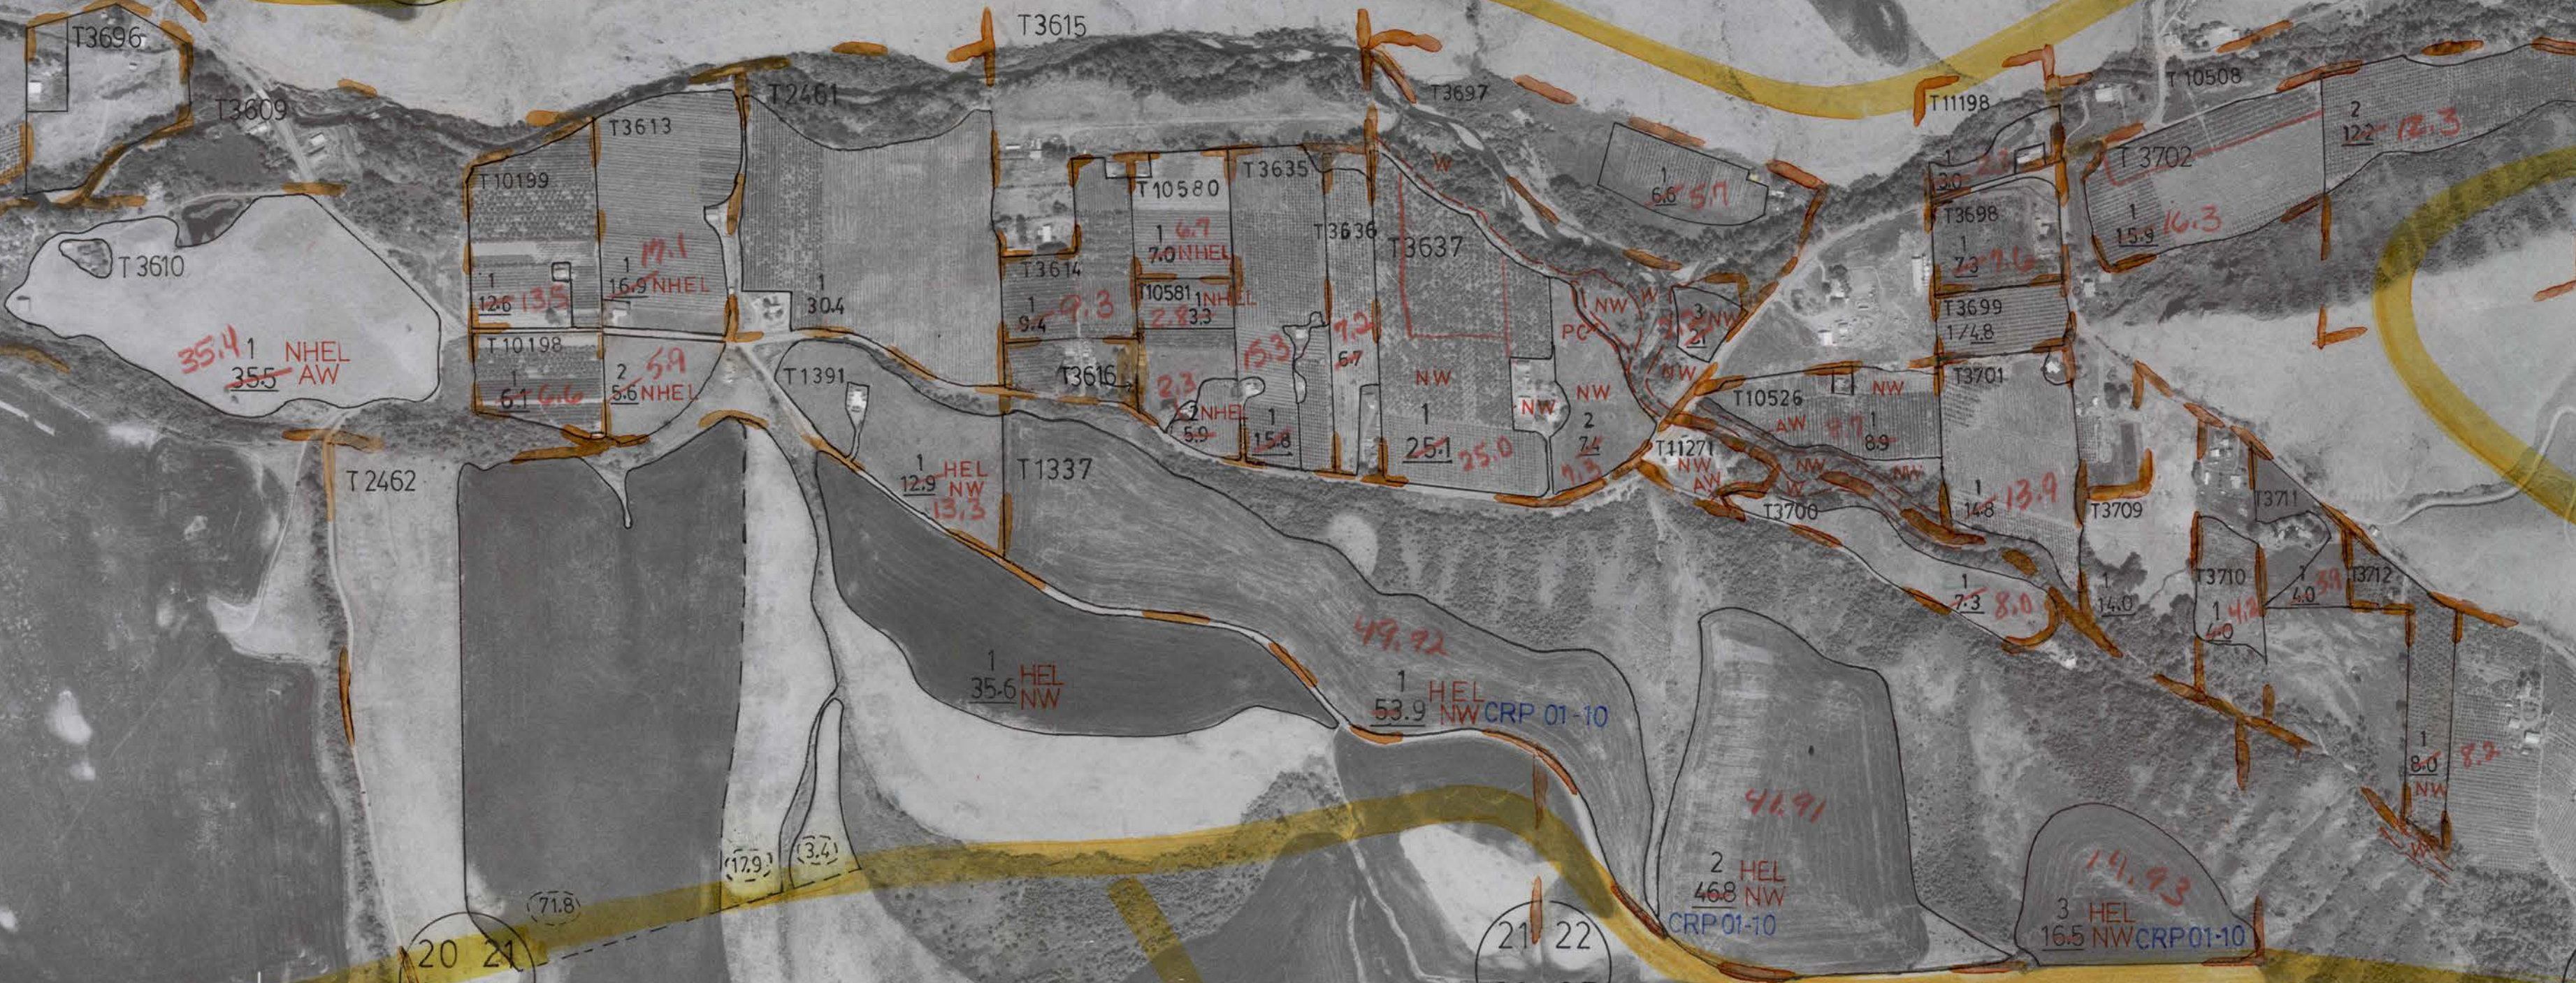

SEE MAP
28E-3

20 21
29 28

21 22
28 27

22 23
27 26