

14L6

T3N-R28E







4K

J 3

17 16
20 21 (40a)

16 15
21 22 (21a)








15 14
22 23

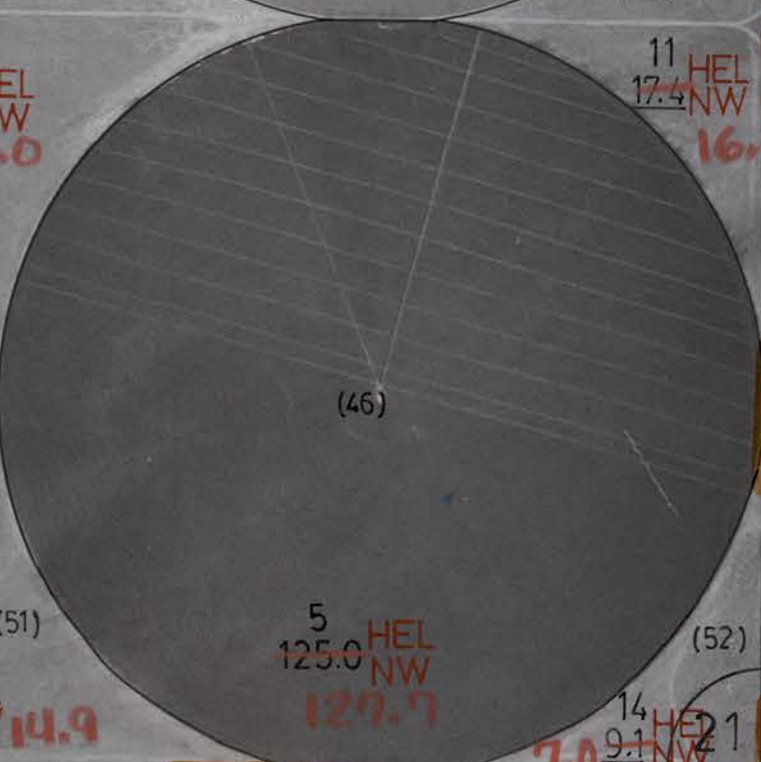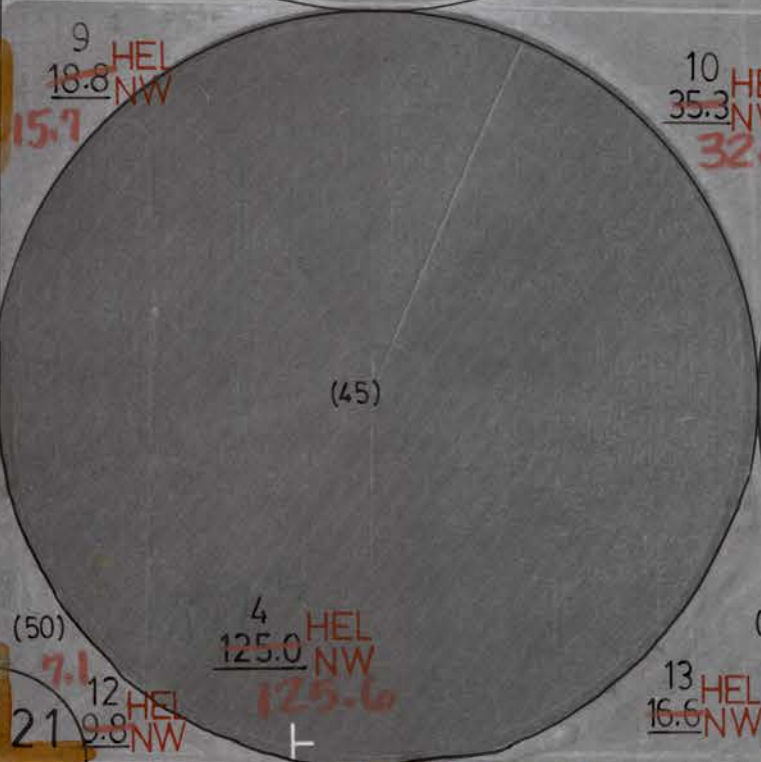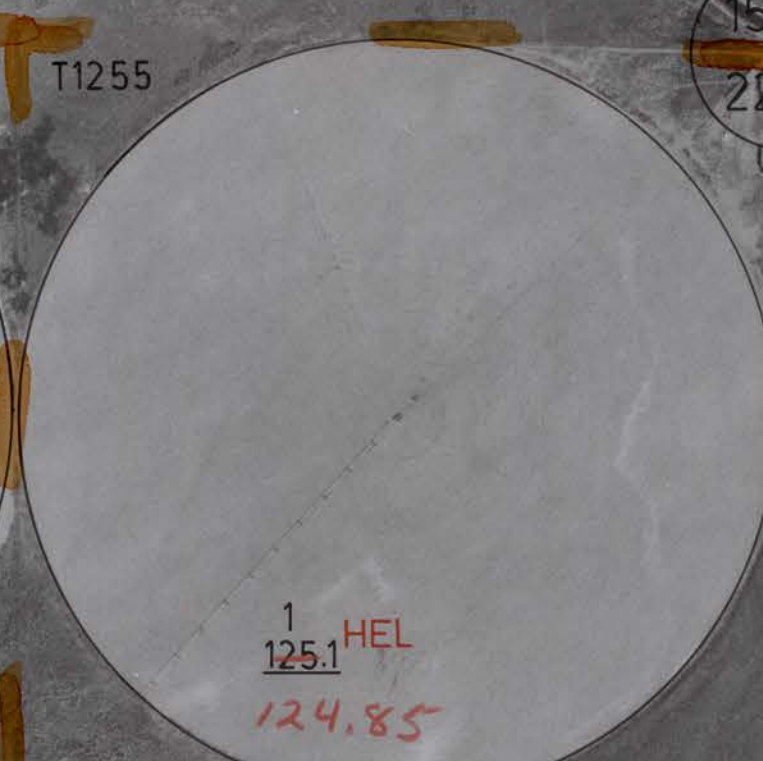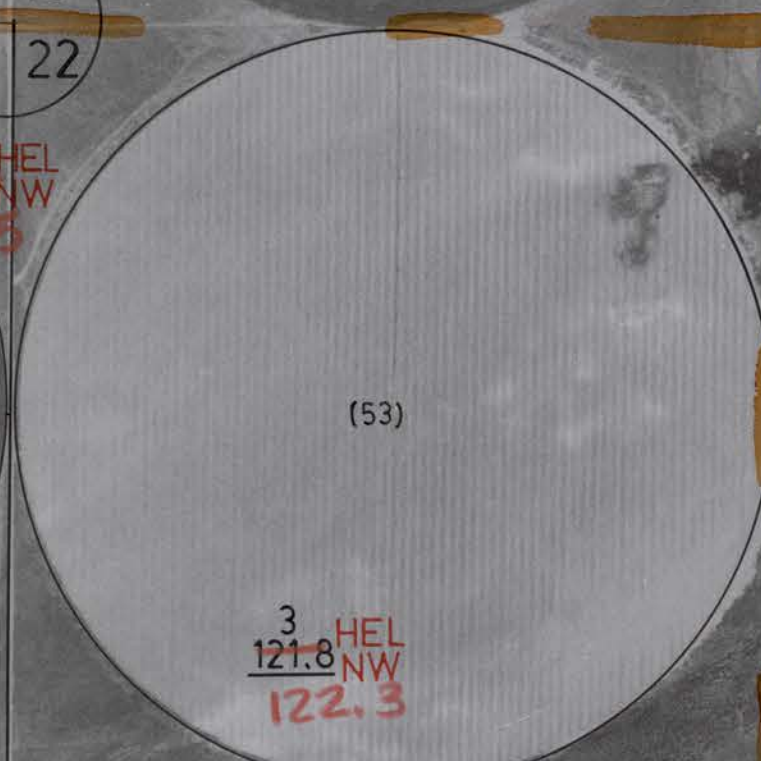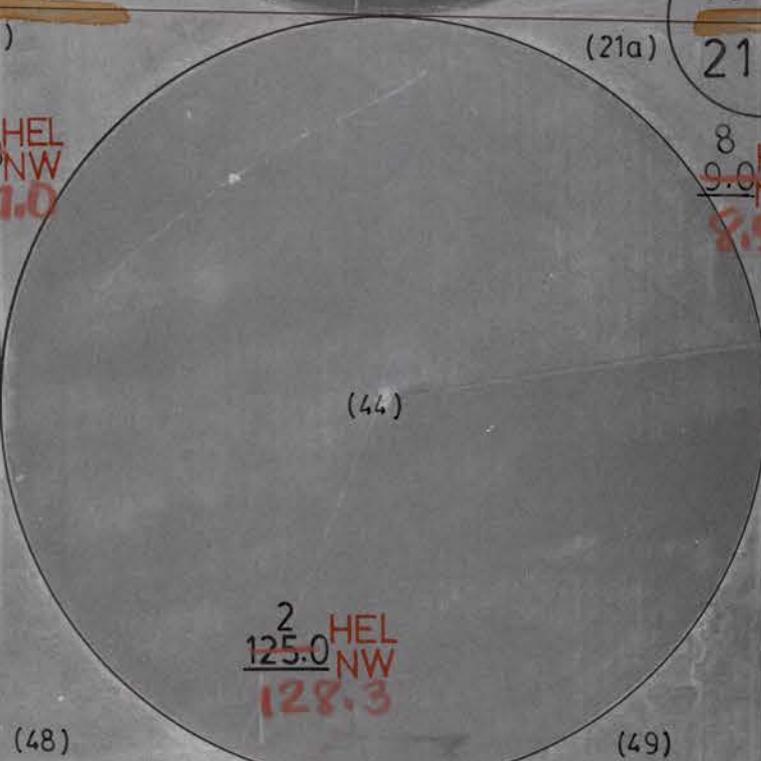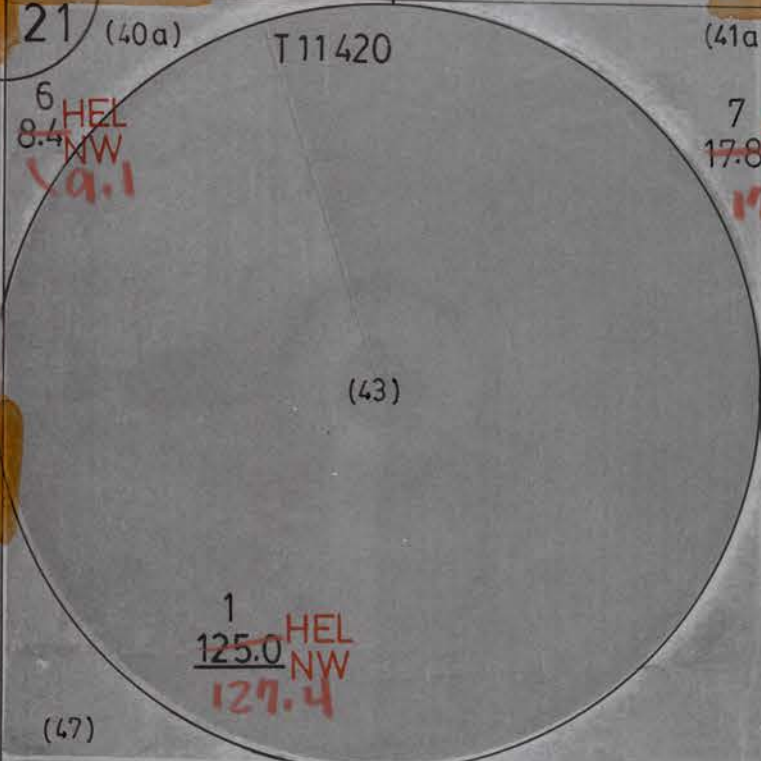

20 21
29 28 T10316

21 22
28 27 T 11474



22 23
27 26

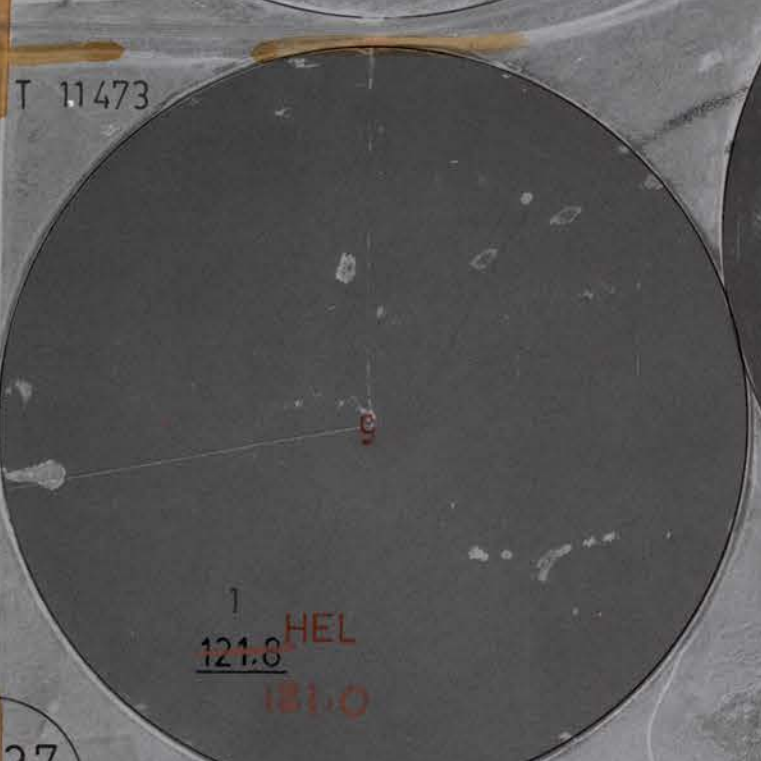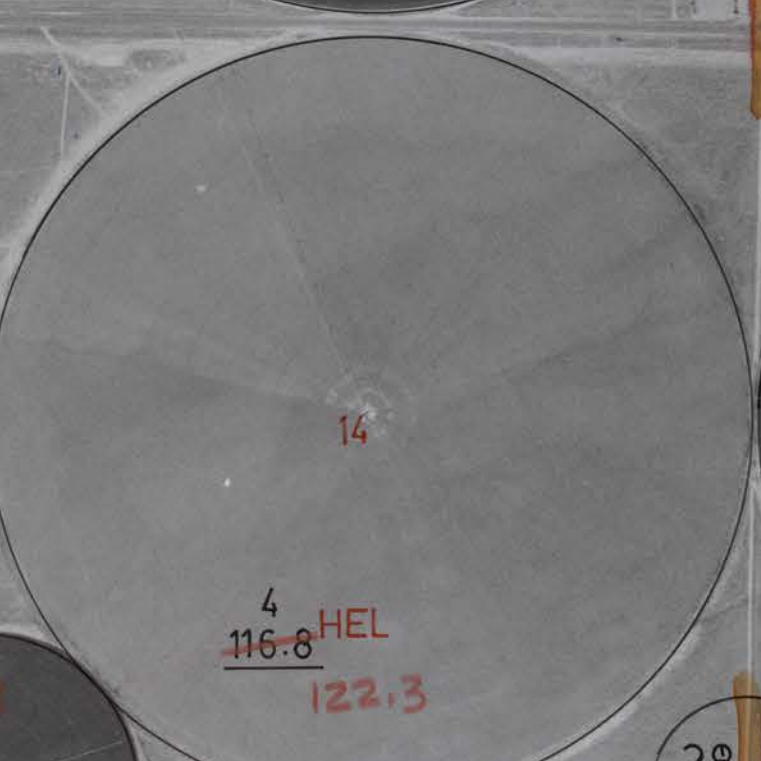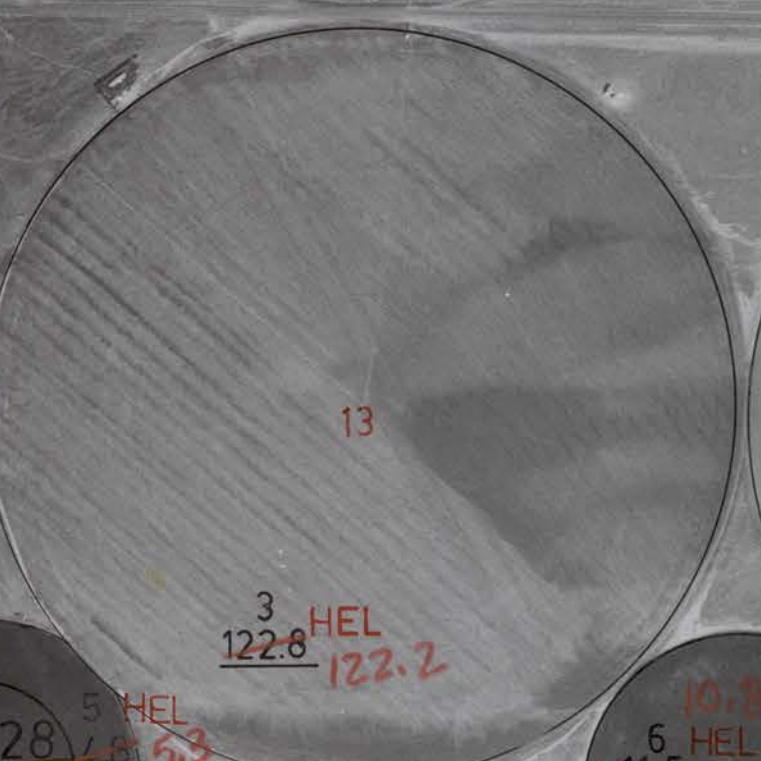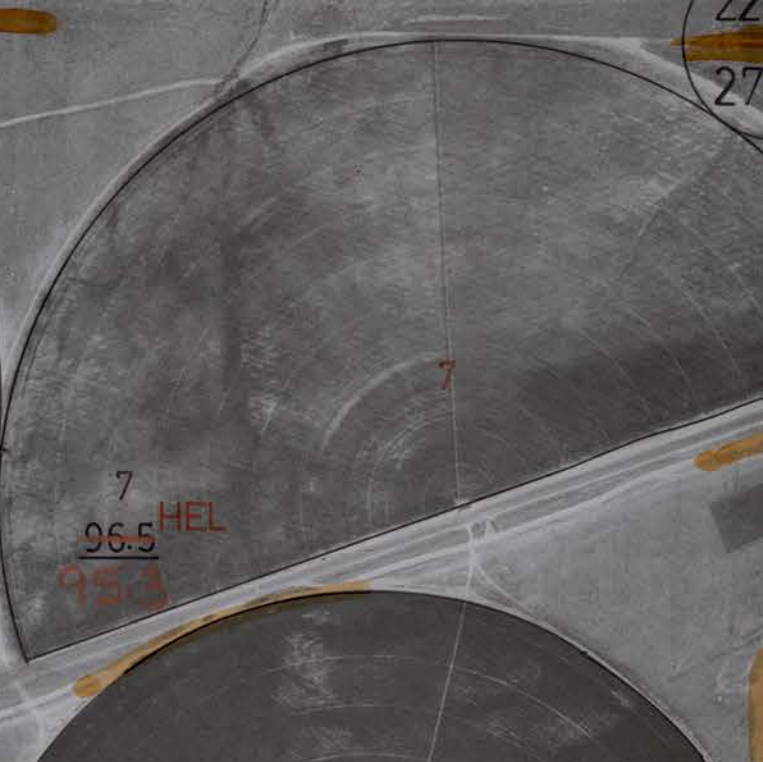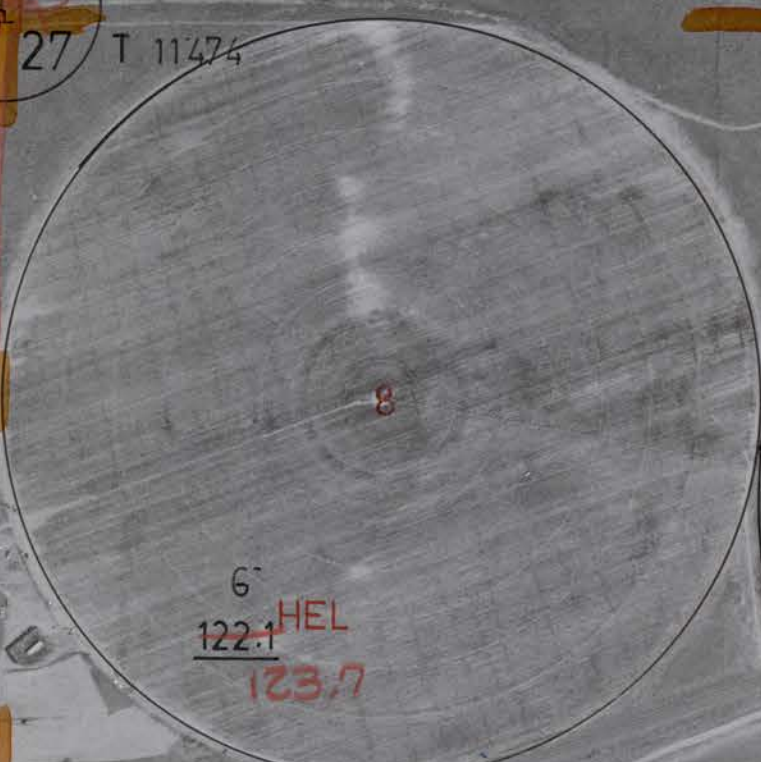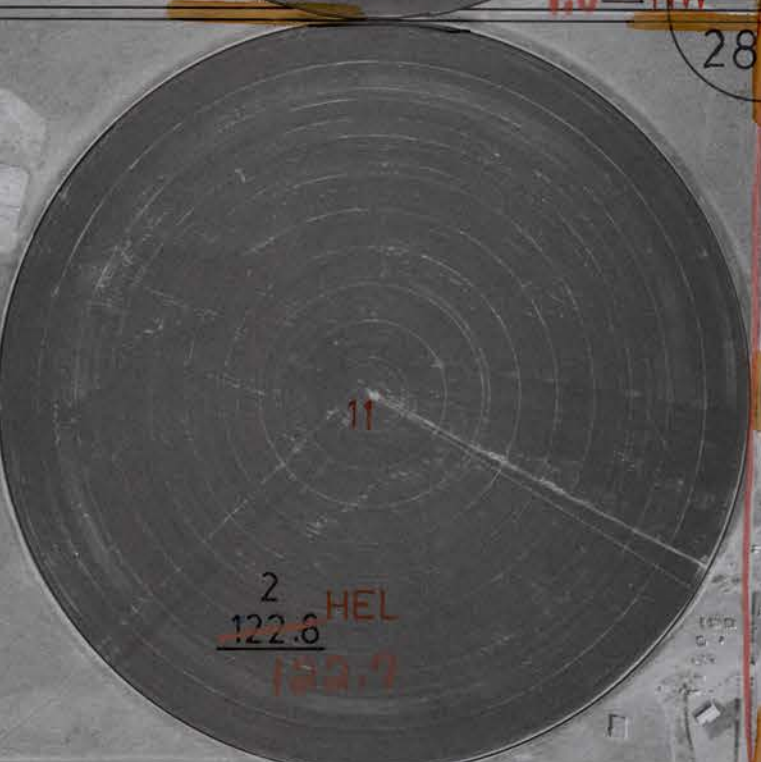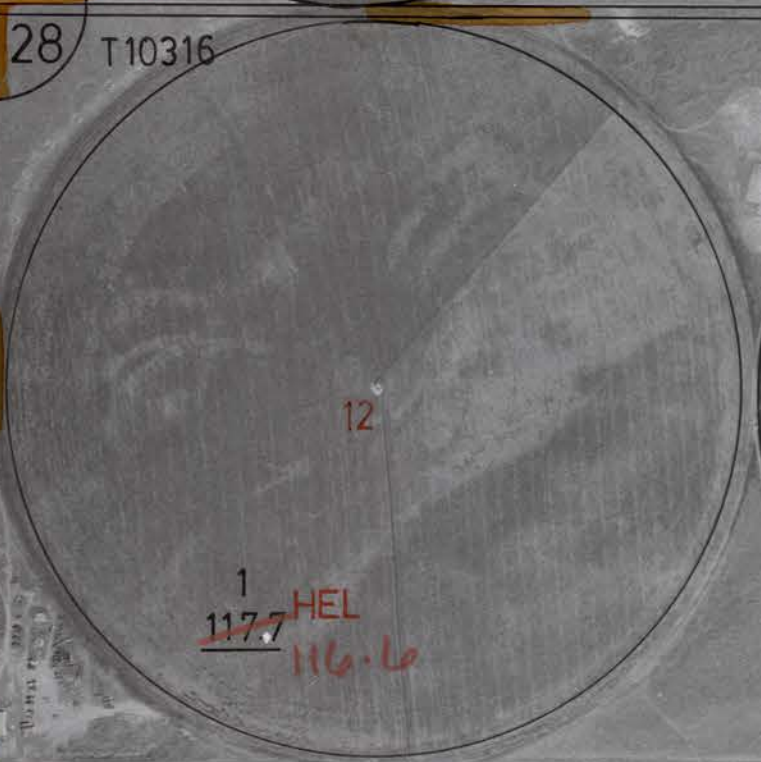

29 28
32 33

28 27
33 34

27 26
34 35

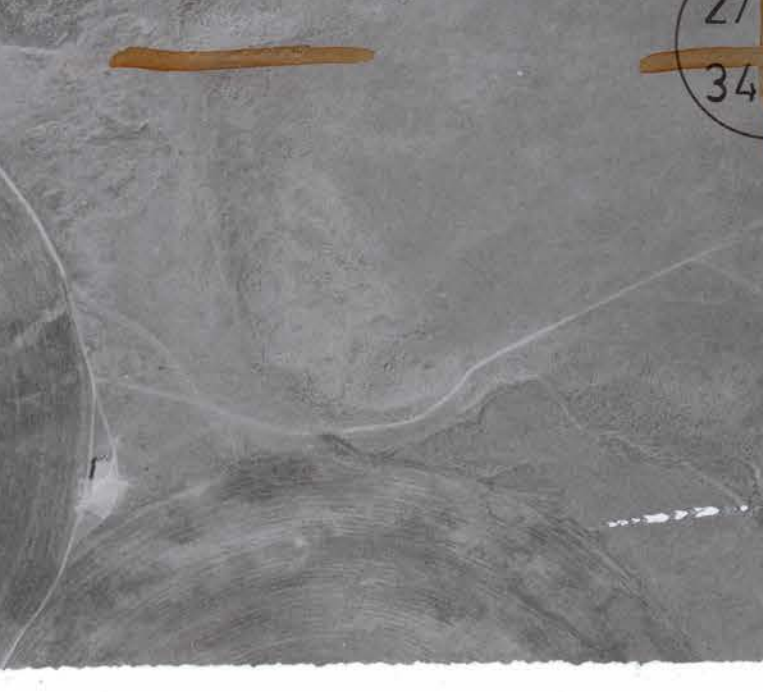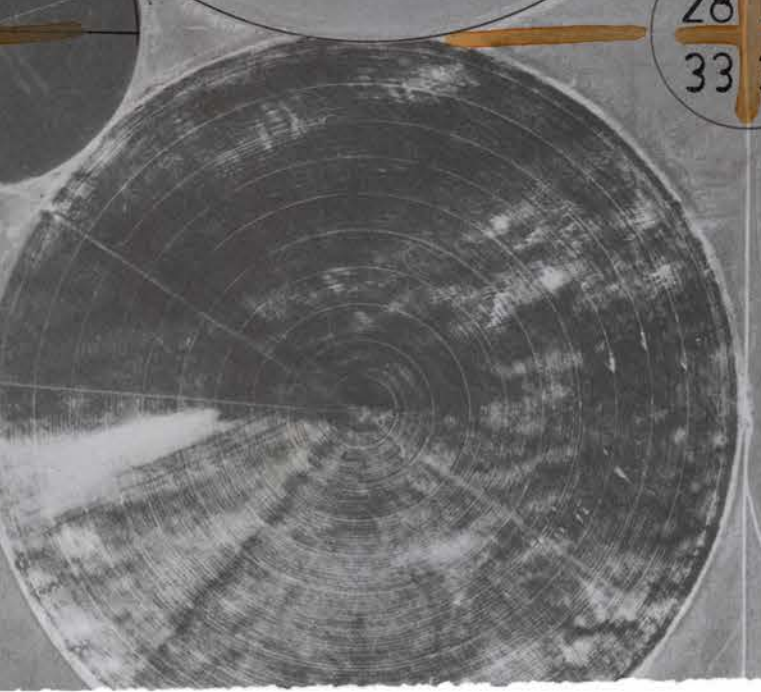

U.S.