


CHAINED SCALE  
10,496

SEE MAP  
7 H

SEE MAP  
8 I

SEE MAP  
8 I

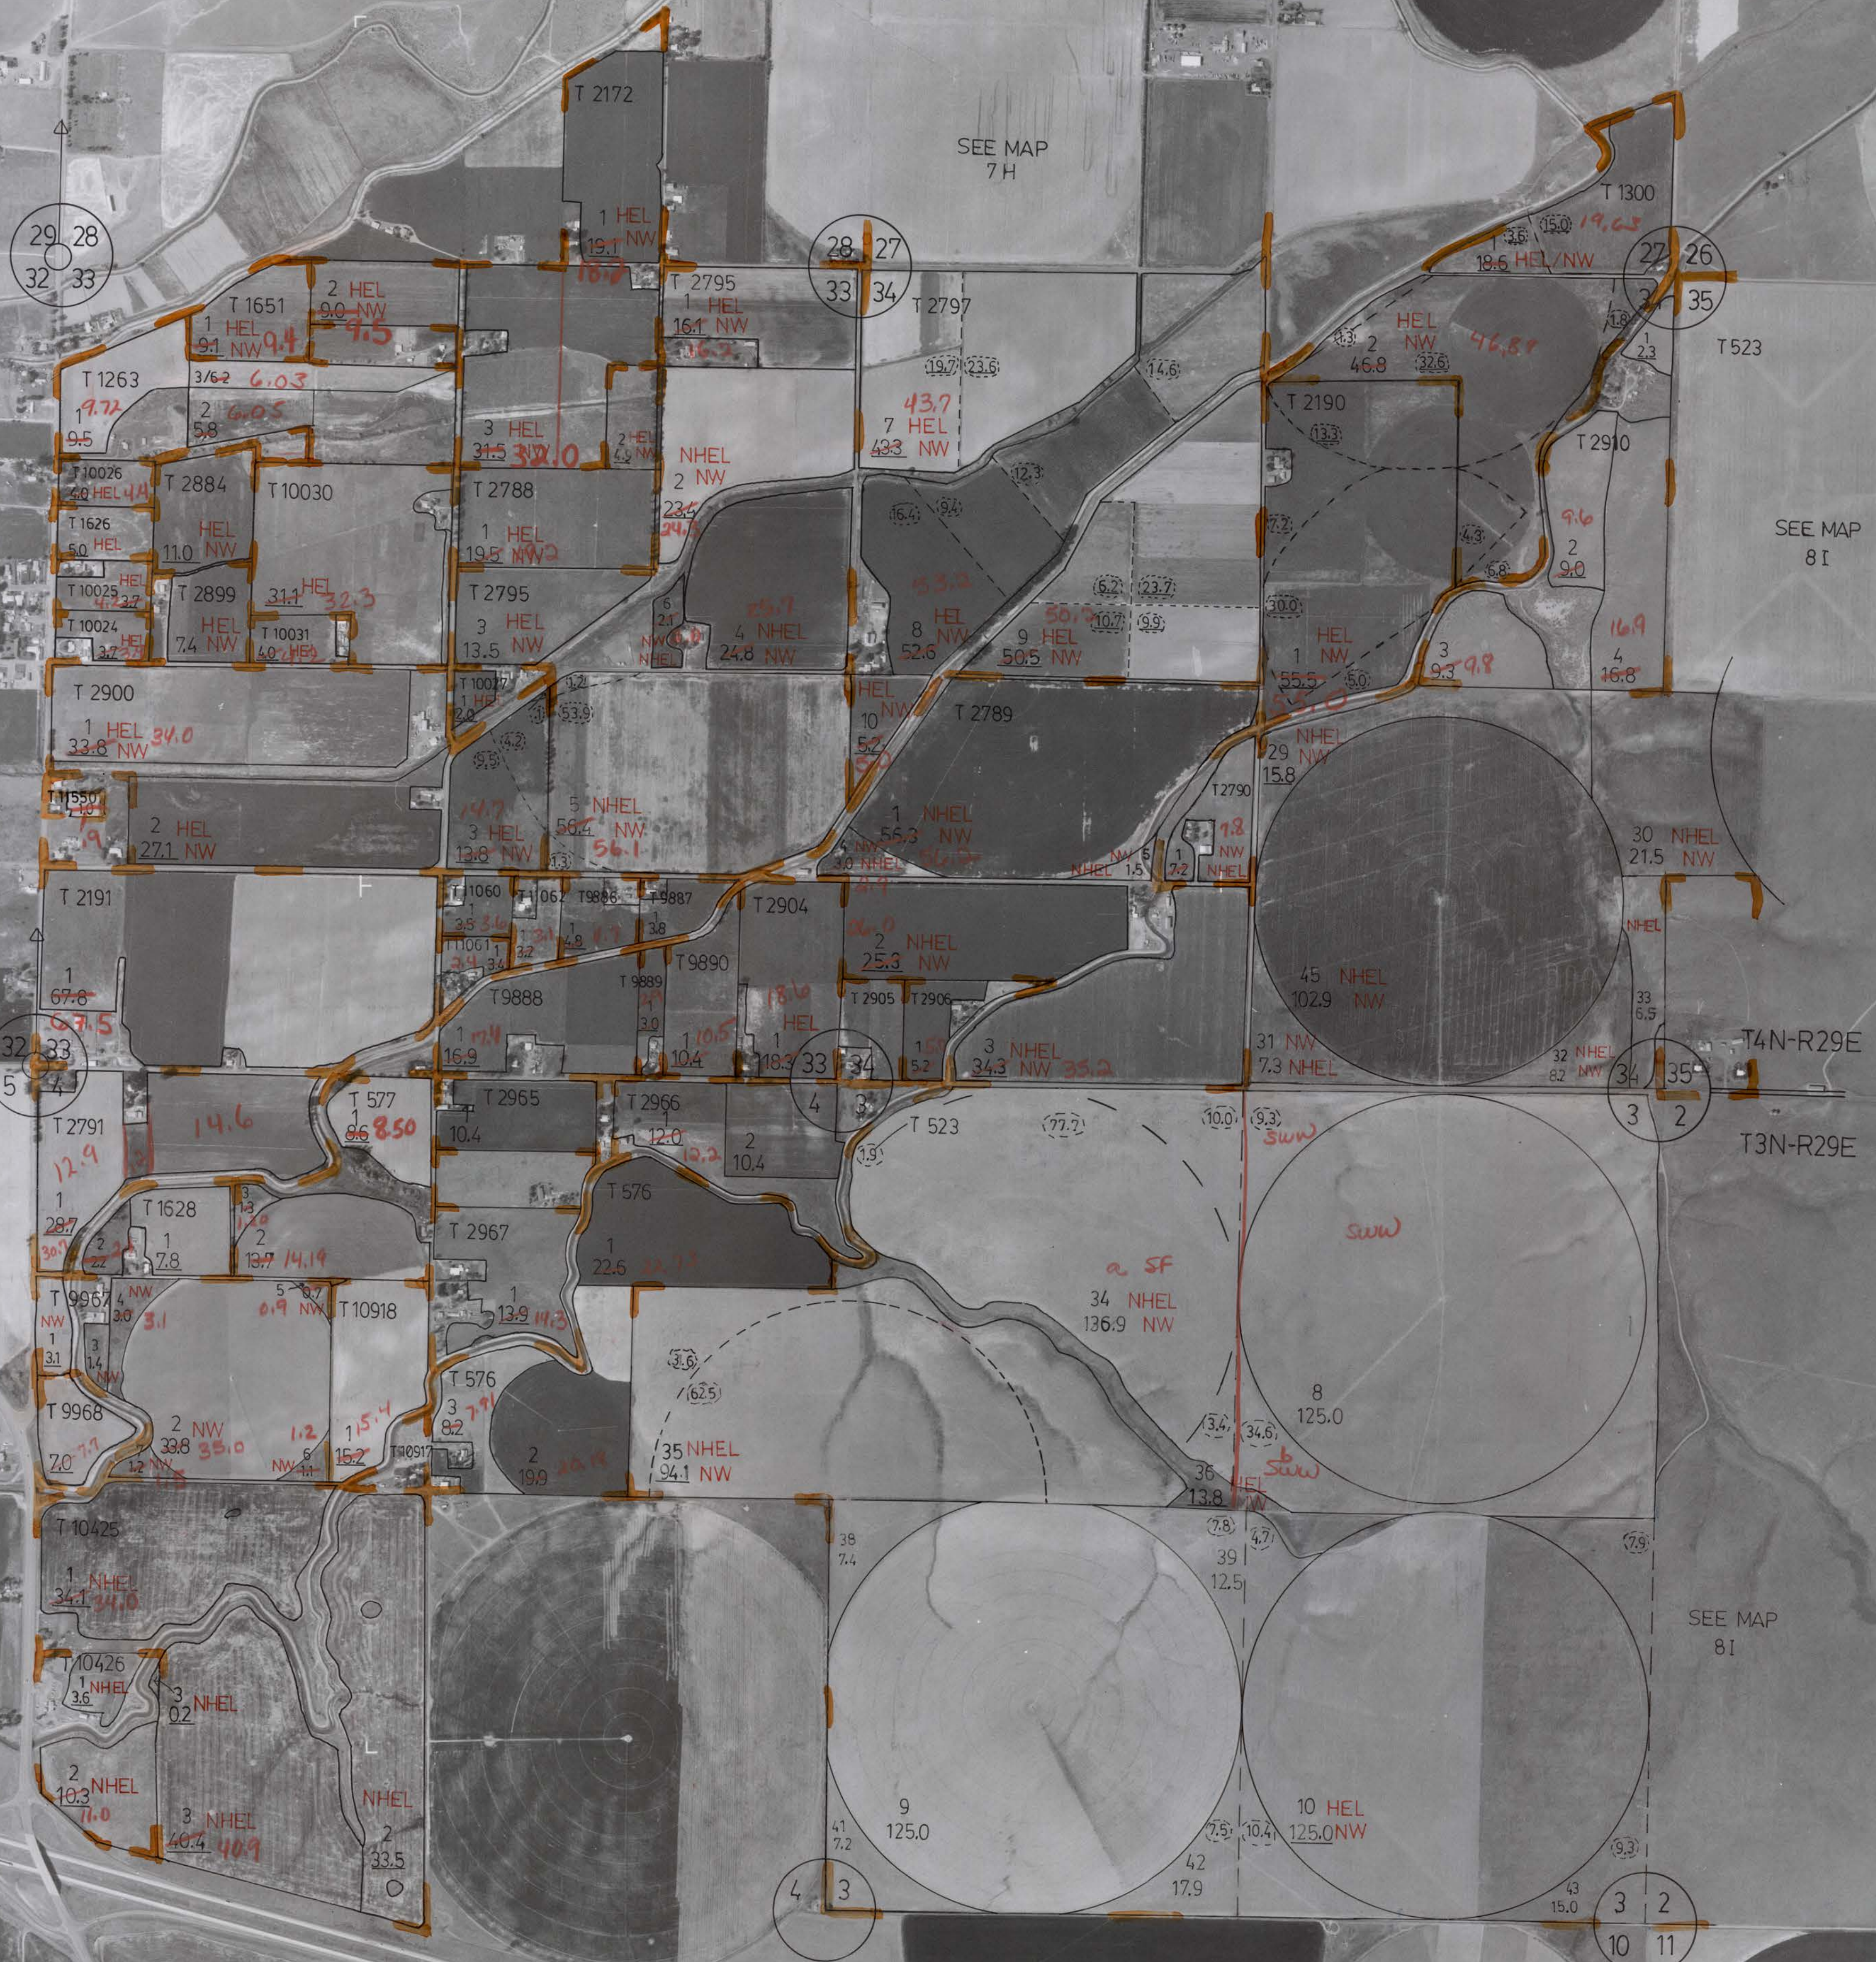

29 28  
32 33

28 27  
33 34

27 26  
34 35

32 33  
5 4

4 3

3 2  
34 35

4 3

3 2  
10 11