


T. 4 N., R. 29 E.

T. 3 N., R. 29 E.

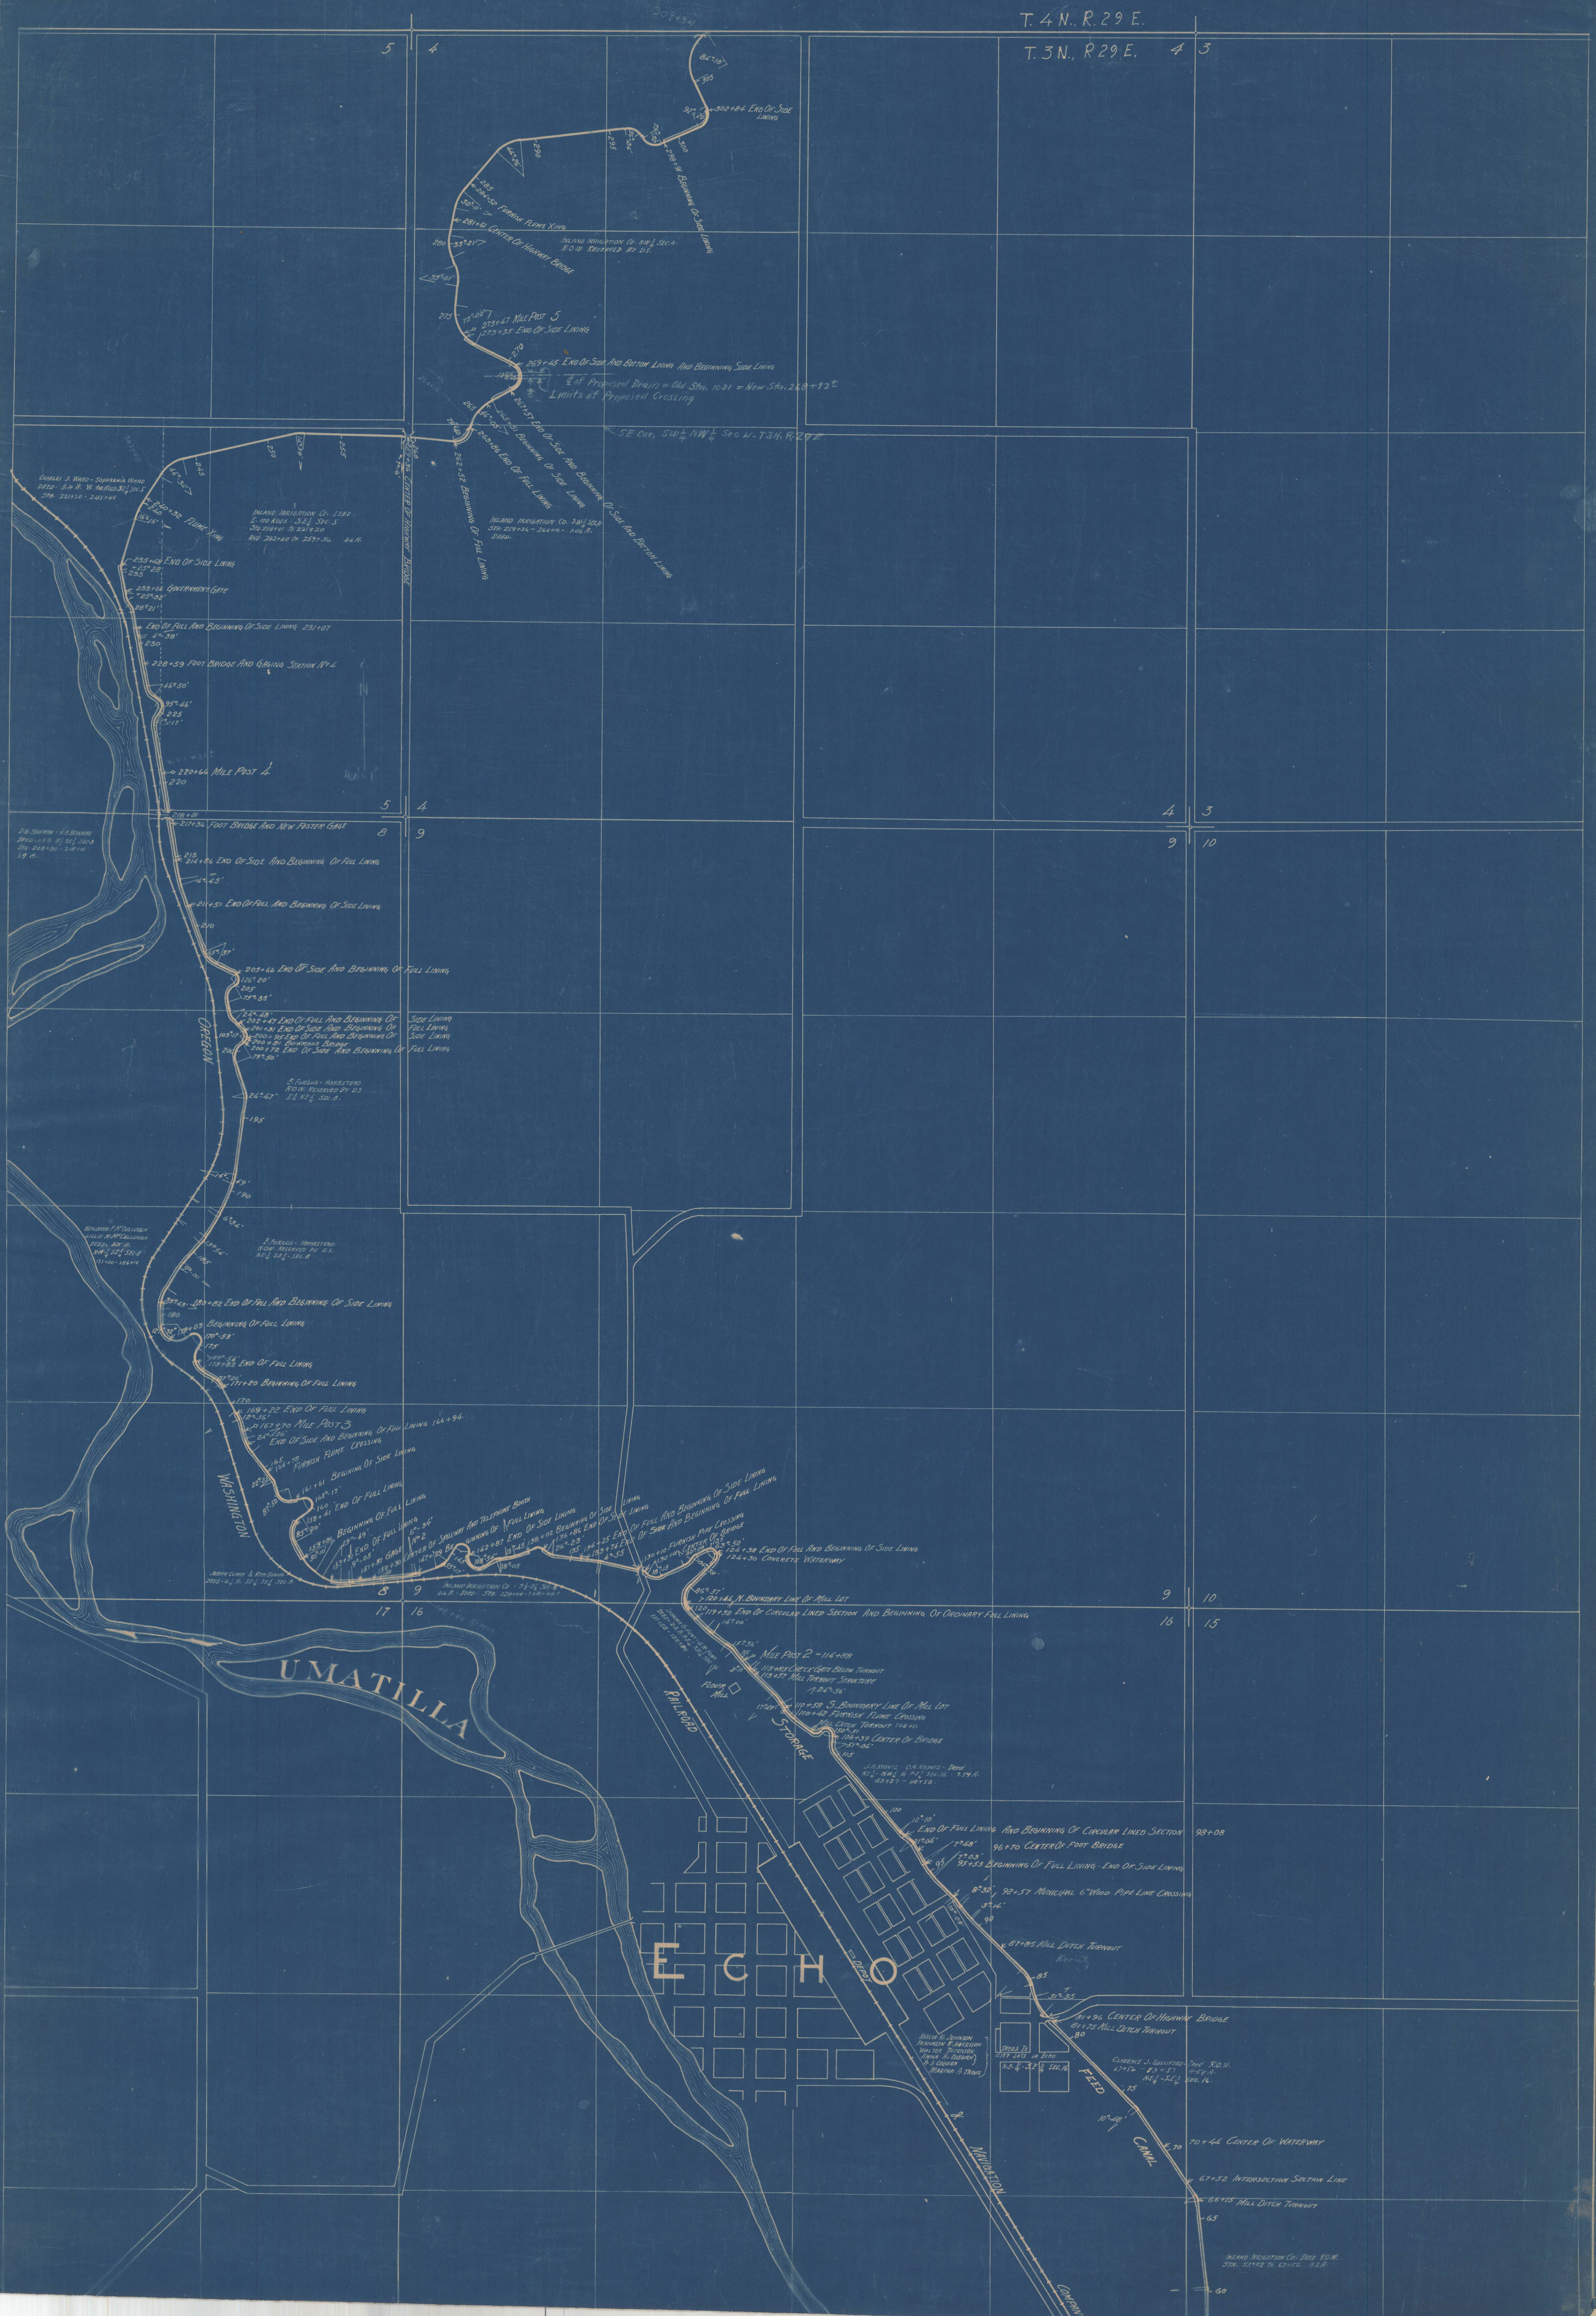

UMATILLA

ECHO

FEED

CANNAL

WATERWAY

COMPANY