


NOTE:
 All courses on Ditch Line are magnetic.
 Section Lines and ties are Meridian courses.

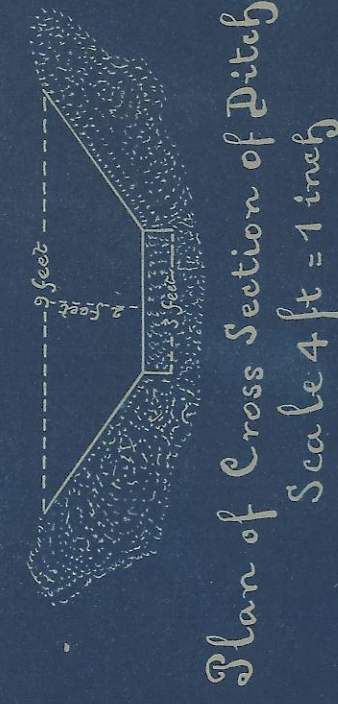

Scale 400 ft = 1 inch.

Map of the Maxwell Ditch in Umatilla Co, Oregon
 As definitely Located and Constructed

By The "Maxwell Irrigation Company" - Owners,
 of Bendleton Oregon.

Maxwell Irrigation Company
 By H. Catherman President.

Maxwell Irrigation Company
 By A. W. Wiggins Sec.