OREGON STATE HIGHWAY DEPARTMENT

CONSTR. ~~LOCATED~~ LINE MAP

N.E. FIFTH (MAIN) STREET

CITY of MILTON-FREEWATER

UMATILLA COUNTY

W.S. Hodge Res. Engr. Scale 1 inch = 50 Ft

April 1953 Bearings Assumed

6F 1-12

SH. 1

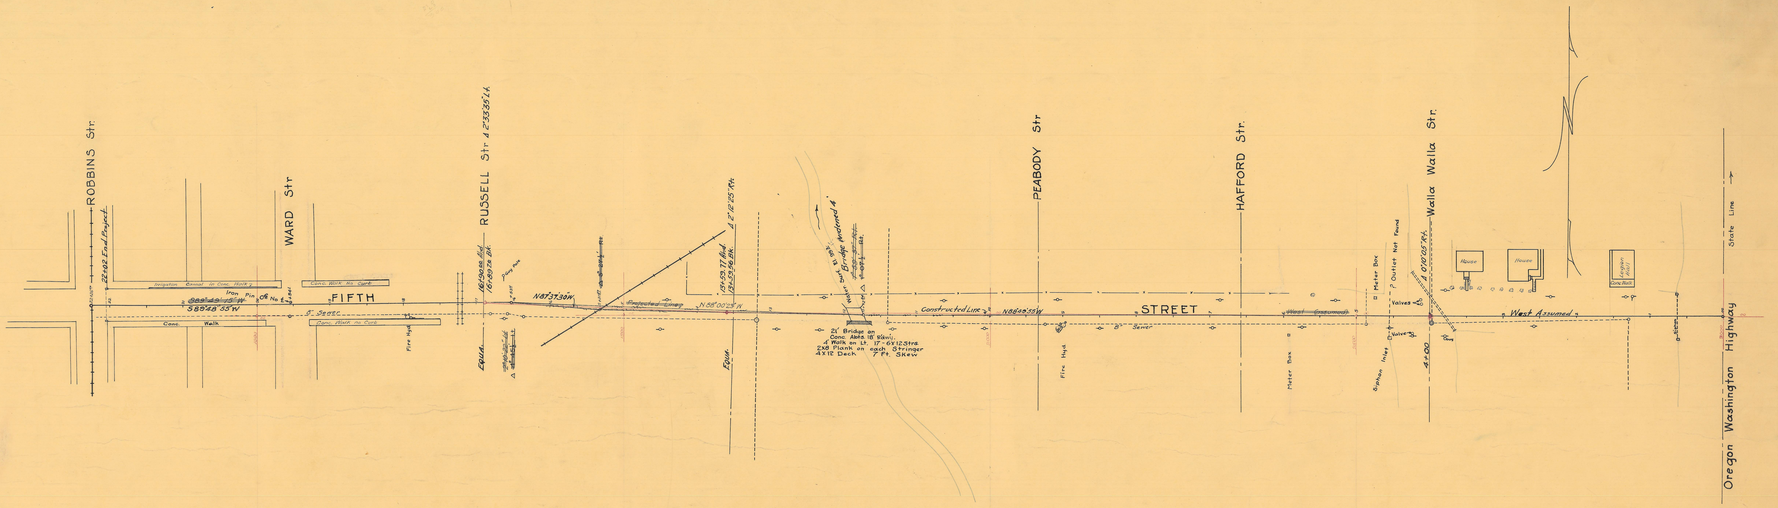

6F 1-12

SH. 2