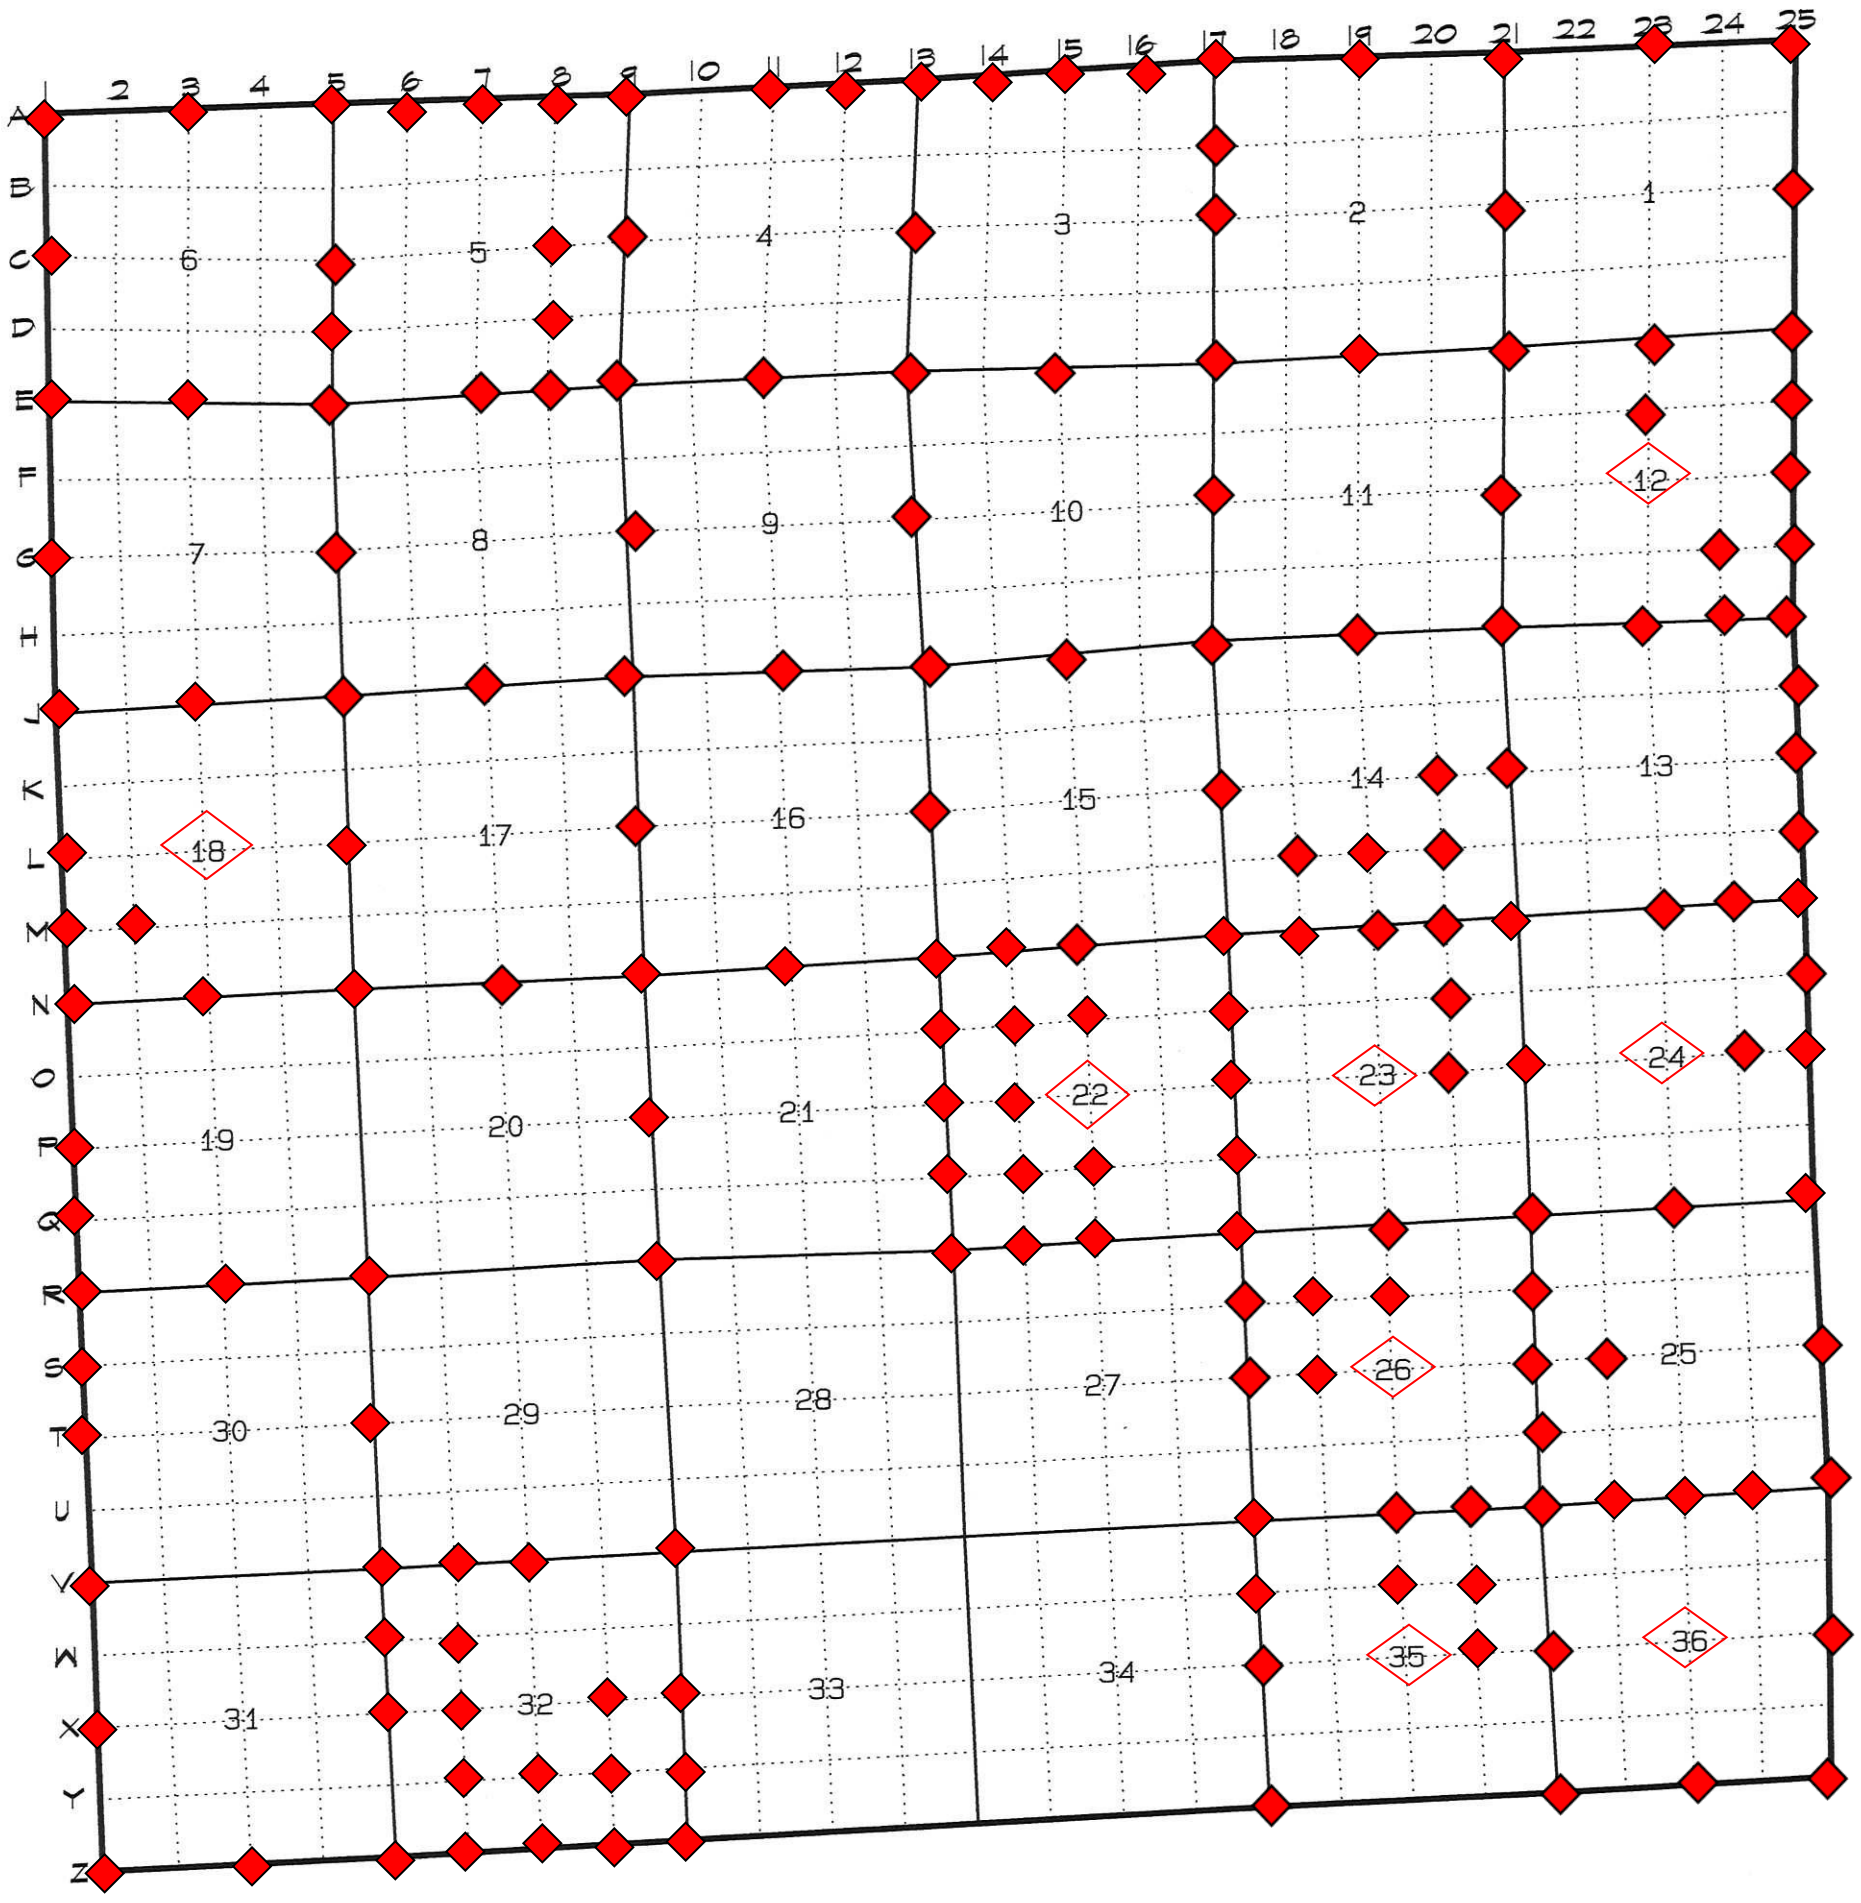TOWNSHIP 5 NORTH RANGE 36 EAST