

I, James J. Higgins, being first duly sworn, depose and say: That I correctly surveyed and marked with proper monuments as indicated on the accompanying Plat of McEwen Addition to the City of Athena, located in Umatilla County, Oregon, the lands indicated thereon; that to indicate the initial point of such survey and as shown on said Plat, there exists a monument of concrete and steel, the exact point indicated by a 2" x 36" iron pipe set 6" below grade

that said point is located South 2°40' East 2736.39 feet from the North quarter corner of Section 19, Township 4 North Range 35 EWM which is a known corner established by the United States Survey; that the exterior boundaries of the tract of land upon which said lots are laid out are as follows: beginning at a point S 2°40' E 2736.39 feet from N 1/4 Cor. Sec. 19 T4N, R35EWM and run thence S 0°19' E 620.00 feet; thence S 89°41' W 40.00 feet to the center of Fifth St.; thence S 0°19' E 428.53 feet; thence S 60°07' E 46.29 feet; thence N 89°41' E 110.75 feet to the southeast corner of said property; thence N 0°19' W 1071.82 feet to the north-east corner of said property; thence S 89°41' W 110.75 feet to the point of beginning; and that this tracing is an exact copy of the final map offered for filing.

James J. Higgins
James J. Higgins
Registered Professional Engineer
State of Oregon, Registered No. 199

Subscribed and sworn to before me this 11th day of March, 1954.

J. Buchanan
Notary Public for Oregon
My Commission Expires July 2, 1954.

I, F.B. Hayes, County Surveyor of Umatilla County, Oregon, hereby certify that I have carefully examined the accompanying Plat and checked the same and the computations for making said Plat to determine if they comply with the provisions of the law and with the requirements of the planning agencies and of the County Court; that the streets, drives, and ways shown thereon are laid out so as to conform to all plats of adjoining property already filed as to width, general direction, and in all other respects, and are dedicated to the public use without any reservation or restriction whatever; that the name is proper so as to comply with the provisions of Section 92.090, ORS, and other laws of the State of Oregon relative thereto; and I therefore approve said Plat for approval by said Court, and for filing and record.

Dated: _____
F. B. Hayes
County Surveyor of Umatilla County
State of Oregon Civil Engr., Reg. No. 197


I, D.W. Davis and I, Roy Johnson, respectively Assessor and Sheriff of Umatilla County, Oregon do each hereby certify that we have examined the tax records relative to the land covered by the accompanying Plat and that all moneys due for State and County taxes and assessments that could constitute a lien on said land have been paid, and we hereby approve of said plat.

Dated: _____
D. W. Davis
Assessor
Roy Johnson
Sheriff

McEWEN ADDITION
TO THE CITY OF ATHENA, OREGON

LOCATION SE 1/4, SEC 19, T4N, R35EWM
ENGINEER JAMES J. HIGGINS
ATTORNEY GENE B. CONKLIN

N 1/4 Cor., Sec. 19, T4N, R35EWM

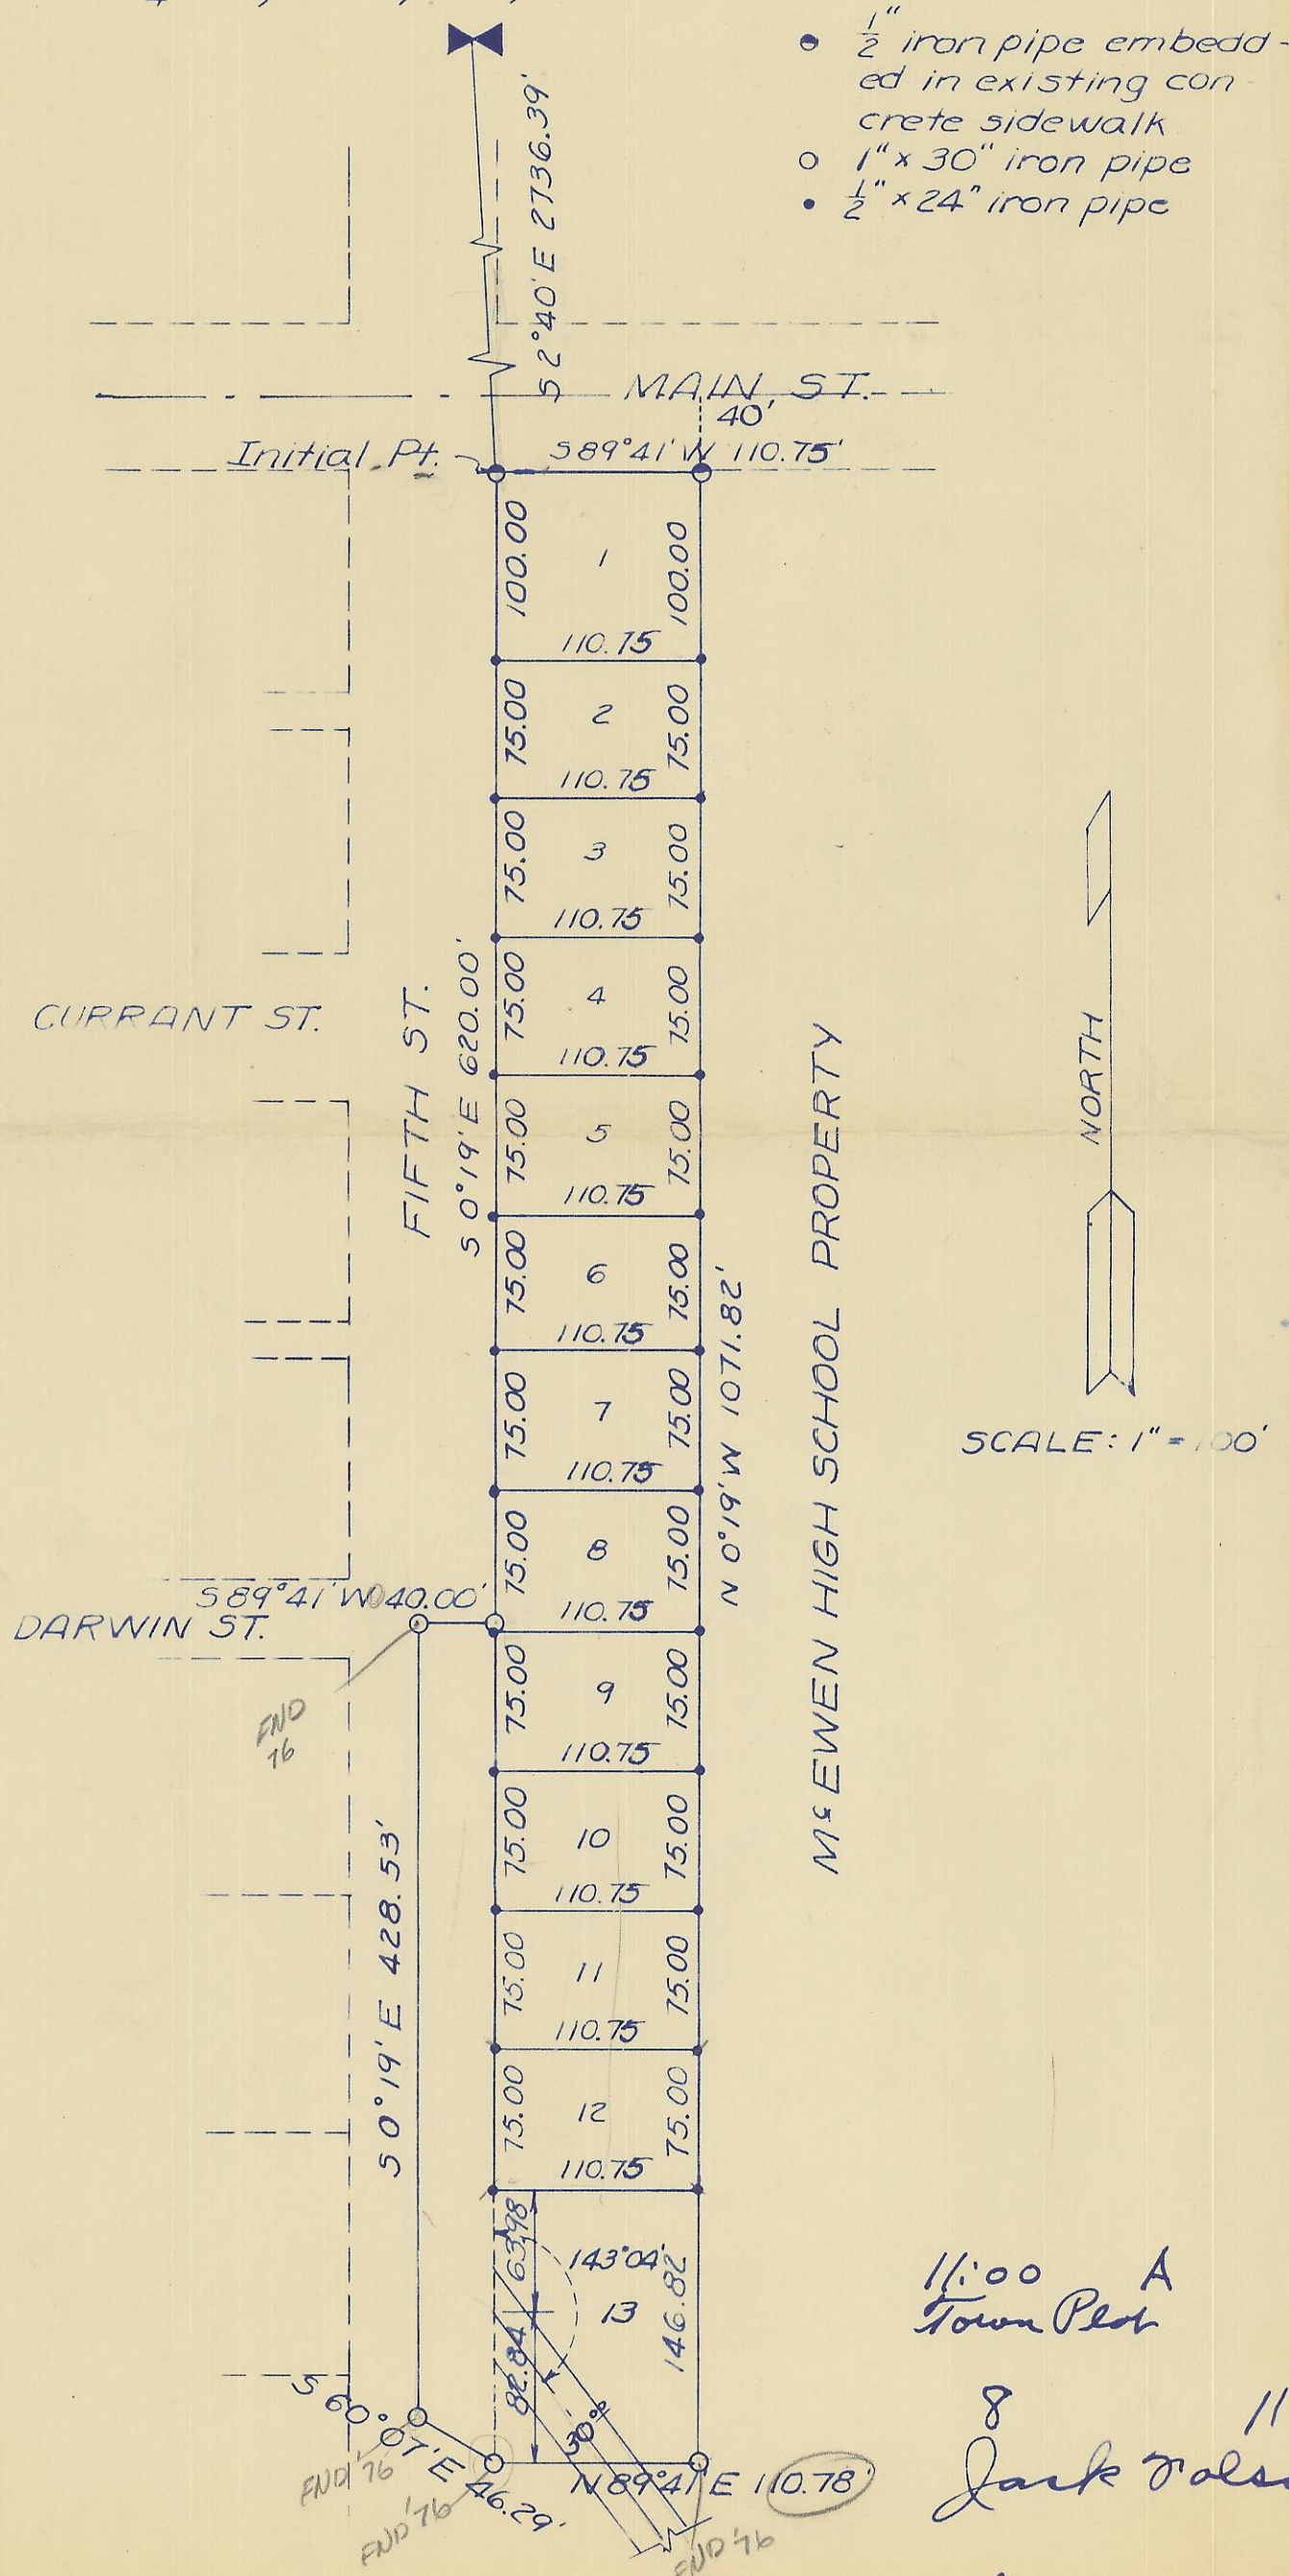

- 1/2" iron pipe embedded in existing concrete sidewalk
- 1" x 30" iron pipe
- 1/2" x 24" iron pipe

KNOW ALL MEN BY THESE PRESENTS, That the Housing Authority of Umatilla County, (Oregon) a public body corporate, being the owner of the lands shown on the accompanying Plat, does hereby dedicate to the use of the public forever, the streets, drives and ways designated on said Plat and does hereby establish and acknowledge the accompanying as the official map and Plat of McEwen Addition to the City of Athena, Oregon.

IN WITNESS WHEREOF, the dedicator has caused its corporate name and seal to be affixed hereto this 19th day of April, 1954

THE HOUSING AUTHORITY OF UMATILLA COUNTY (OREGON) a public body corporate.
By D. W. Bliss Chairman
By J. B. Wugger Secretary

State of Oregon
County of Umatilla ss.
On this 19th day of April, 1954, appeared D. W. Bliss, who being sworn, did say that he is the Secretary of The Housing Authority of Umatilla County (Oregon) and that the seal affixed on the foregoing instrument is the corporate seal of said public body corporate and that the said instrument was signed and sealed on behalf of said public body corporate by authority of its commissioners by their resolution adopted on the day of April 13, 1954, and he acknowledged said instrument to be its voluntary act and deed.
Before me this day of April 19, 1954

A. H. Watson
Notary Public for Oregon
My Commission expires Dec. 26, 1956

The accompanying Plat is approved by resolution of the undersigned, duly adopted on April 19, 1954, and report of said approval duly filed.
CITY PLANNING COMMISSION OF THE CITY OF ATHENA, OREGON.

By Gordon M. Watkins Chairman
By J. B. Wugger Secretary

This is to certify that the accompanying Plat is approved for filing and record in the Record of Town Plats of Umatilla County, Oregon, by the undersigned by its order dated June 14, 1954 recorded in County Court Journal

COUNTY COURT OF UMATILLA COUNTY, STATE OF OREGON
By James Watson County Judge
By _____ County Commissioner
By Claude Meyers County Commissioner

Attest:
I, Jessie M. Bell, County Clerk of Umatilla County, Oregon, do hereby certify that the above named were on the date of said order above specified and now are the duly qualified, elected, sworn, and acting Judges and Commissioners of said County; that the above signatures are the genuine signatures thereof; and that the seal hereto affixed is the seal of my office.

Jessie M. Bell
County Clerk
Umatilla County, Oregon

9-2008-B