


120 ft addition to Centerline
 Surveyed Oct 6th 1879
 Scale 100 ft to the inch
 J. H. Morgan
 Surveyor

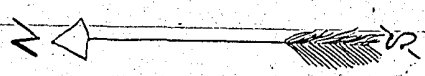

Filed Dec 16th Recorded Dec 17th 1879
 J. R. Keeney cons