PURPOSE OF THIS SURVEY WAS ESTABLISH THE PROPERTY CORNERS OF THAT PARCEL CONVEYED TO ANDERSON ON Pg 100 of BK 327 DEED RECORDS OF UMATILLA COUNTY, OREGON. SECTION 35 WAS SUBDIVIDED BASED ON CO. SURVEYORS DRWG NO. J-94A, MODIFIED TO TAKE ACCOUNT OF BRASS CAPS ESTABLISHED IN 1980 ON TOWNSHIP LINE BY THE COUNTY SURVEYOR. BEARINGS ARE BASED UPON THAT SURVEY. PINS SET BY RALPH THOMPSON AS SHOWN ON CO. SURVEYOR'S DRWG.NO. H-249 APPEAR TO HAVE BEEN DISTURBED.

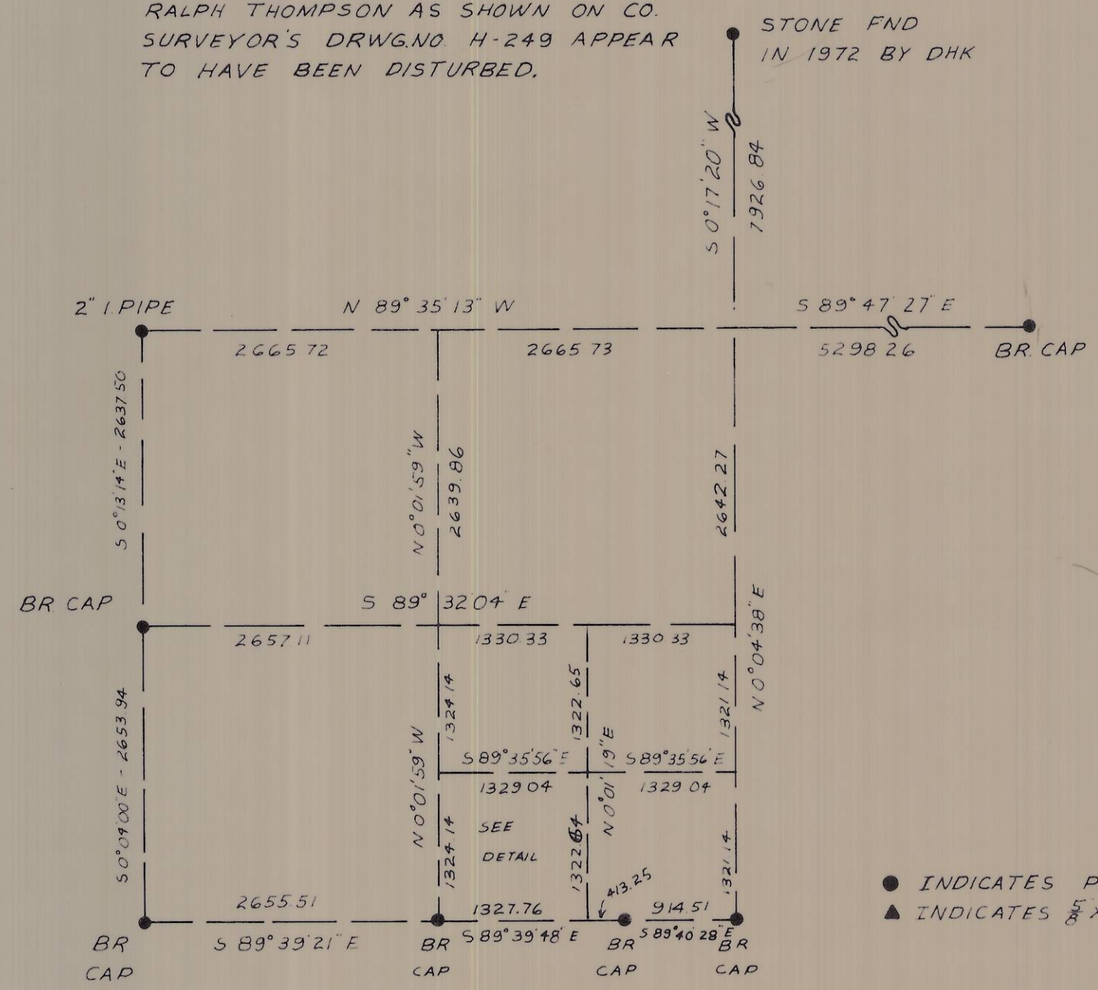

SECTION 35
N.T.S.

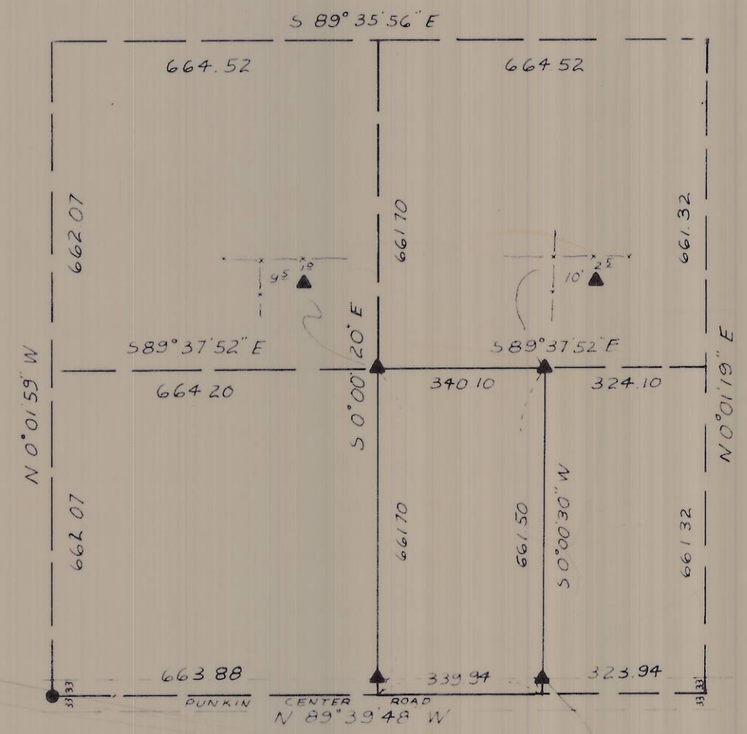

SW$\frac{1}{4}$, SE$\frac{1}{4}$, SEC. 35
SCALE 1" = 300'

● INDICATES POINTS FND
▲ INDICATES $\frac{5}{8}$ X 30" I PIN w/ ALUM CAP SET

RECEIVED BY
Umatilla County Surveyor
Date 6-82
Rec'd By BLS
No. 82-35-A

David H Kleinbein
David H Klein

KRUMBEIN ENGINEERING CO. ENGINEERS – SURVEYORS – PLANNERS 221 S. Main, Pendleton, Oregon	SCALE AS SHOWN
	DATE MAY 14, 82
SURVEY FOR ALTON ANDERSON SW$\frac{1}{4}$, SE$\frac{1}{4}$, SEC. 35, T.5N, R.28E.W.M.	DRN BY DHK
	CKD BY DHK
	DRNG. NO. 82-16B

82-35-A JOB NO 8242