


**NARRATIVE OF SURVEY**

THE PURPOSE OF THIS SURVEY WAS TO LOCATE THE WEST LINE OF LOT 5, OF THE REPLAT OF BLOCK 6 OF WEST HILLS ADDITION TO PENDLETON, OREGON. BEARINGS FOR THIS SURVEY ARE BASED ON RECOVERED MONUMENTS FROM THE REPLAT OF BLOCK 6.

THE SOUTHWEST CORNER MONUMENT OF LOT 5 WAS RECOVERED UNDISTURBED, AND THE POSITION OF THE NORTHWEST CORNER OF LOT 5 WAS RE-ESTABLISHED AS SHOWN ON THIS MAP.

THE SURVEY WAS MADE ON MAY 10, 1989, WITH A 2 PERSON CREW USING A MAC 11-H INFRA-RED DISTANCE METER, WILD T-16 THEODOLITE, AND STEEL TAPE.

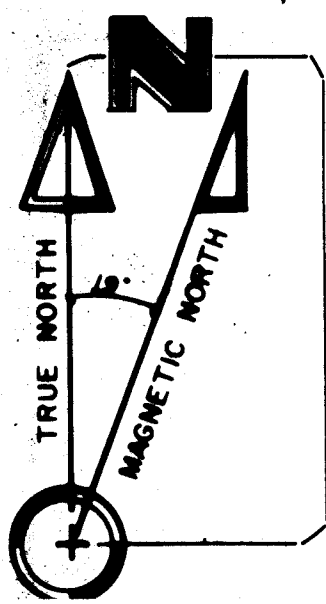

SCALE: 1" = 30'

REGISTERED  
PROFESSIONAL  
LAND SURVEYOR

*William R. Wells*

OREGON  
JULY 22, 1977  
WILLIAM R. WELLS

NOTE: SURVEY IS LOCATED IN THE SW 1/4 OF SECTION 3, T2N, R32E, W. M.  
BEARINGS AND DISTANCES IN PARENTHESES ARE THOSE FROM THE RECORDED PLAT.

WILLIAM R. WELLS, PLS  
LAND SURVEYING SERVICES  
P.O. BOX 1696  
PENDLETON, OREGON 97801  
PHONE: 503 276 6362

PROJECT: SURVEY FOR  
MATLOCK  
SURVEY OF THE WEST  
LINE OF LOT 5, OF THE  
REPLAT OF BLOCK 6,  
WEST HILLS ADDITION  
PENDLETON, OREGON

Date: 5 - 20 - 89	Dr. By: JMW
Ck. By: WRW	No: 89 - 57

RECEIVED BY  
Umatilla County Surveyor  
Date 7-89  
Rec'd By [Signature]  
No. 89-66-A

89-66-A