

SCALE : 1" = 100'

0 1/2" x 24" Rebar Set with Alum. Tag # 951

(000) OF RECORD FROM, OR COMPUTED FROM, 1976 HERBES PLAT OF "BOYLAN - MARCHEK ACRES"



NARRATIVE: The purpose of this survey is to replace the north corners of Lot 2, for a pending sale and so a fence can be built. The corners I set are 7 feet south of the original lot corners. 7 feet of additional R/W was decided to the County R.185, P.1563, and the original corners were covered by pavement or obliterated.

REGISTERED PROFESSIONAL LAND SURVEYOR


G. Dennis Edwards

OREGON JULY 16, 1971 G. DENNIS EDWARDS 951

SURVEY FOR PATSY KIMIG IN "BOYLAN MARCHEK ACRES" IN SW 1/4 SEC. 8, T4N, R28E, W.M., UMATILLA CO., OREGON

5/23/90 JOB # 59005031

EDWARDS SURVEYING P.O. Box 763 567-3336 HERMISTON, OR.

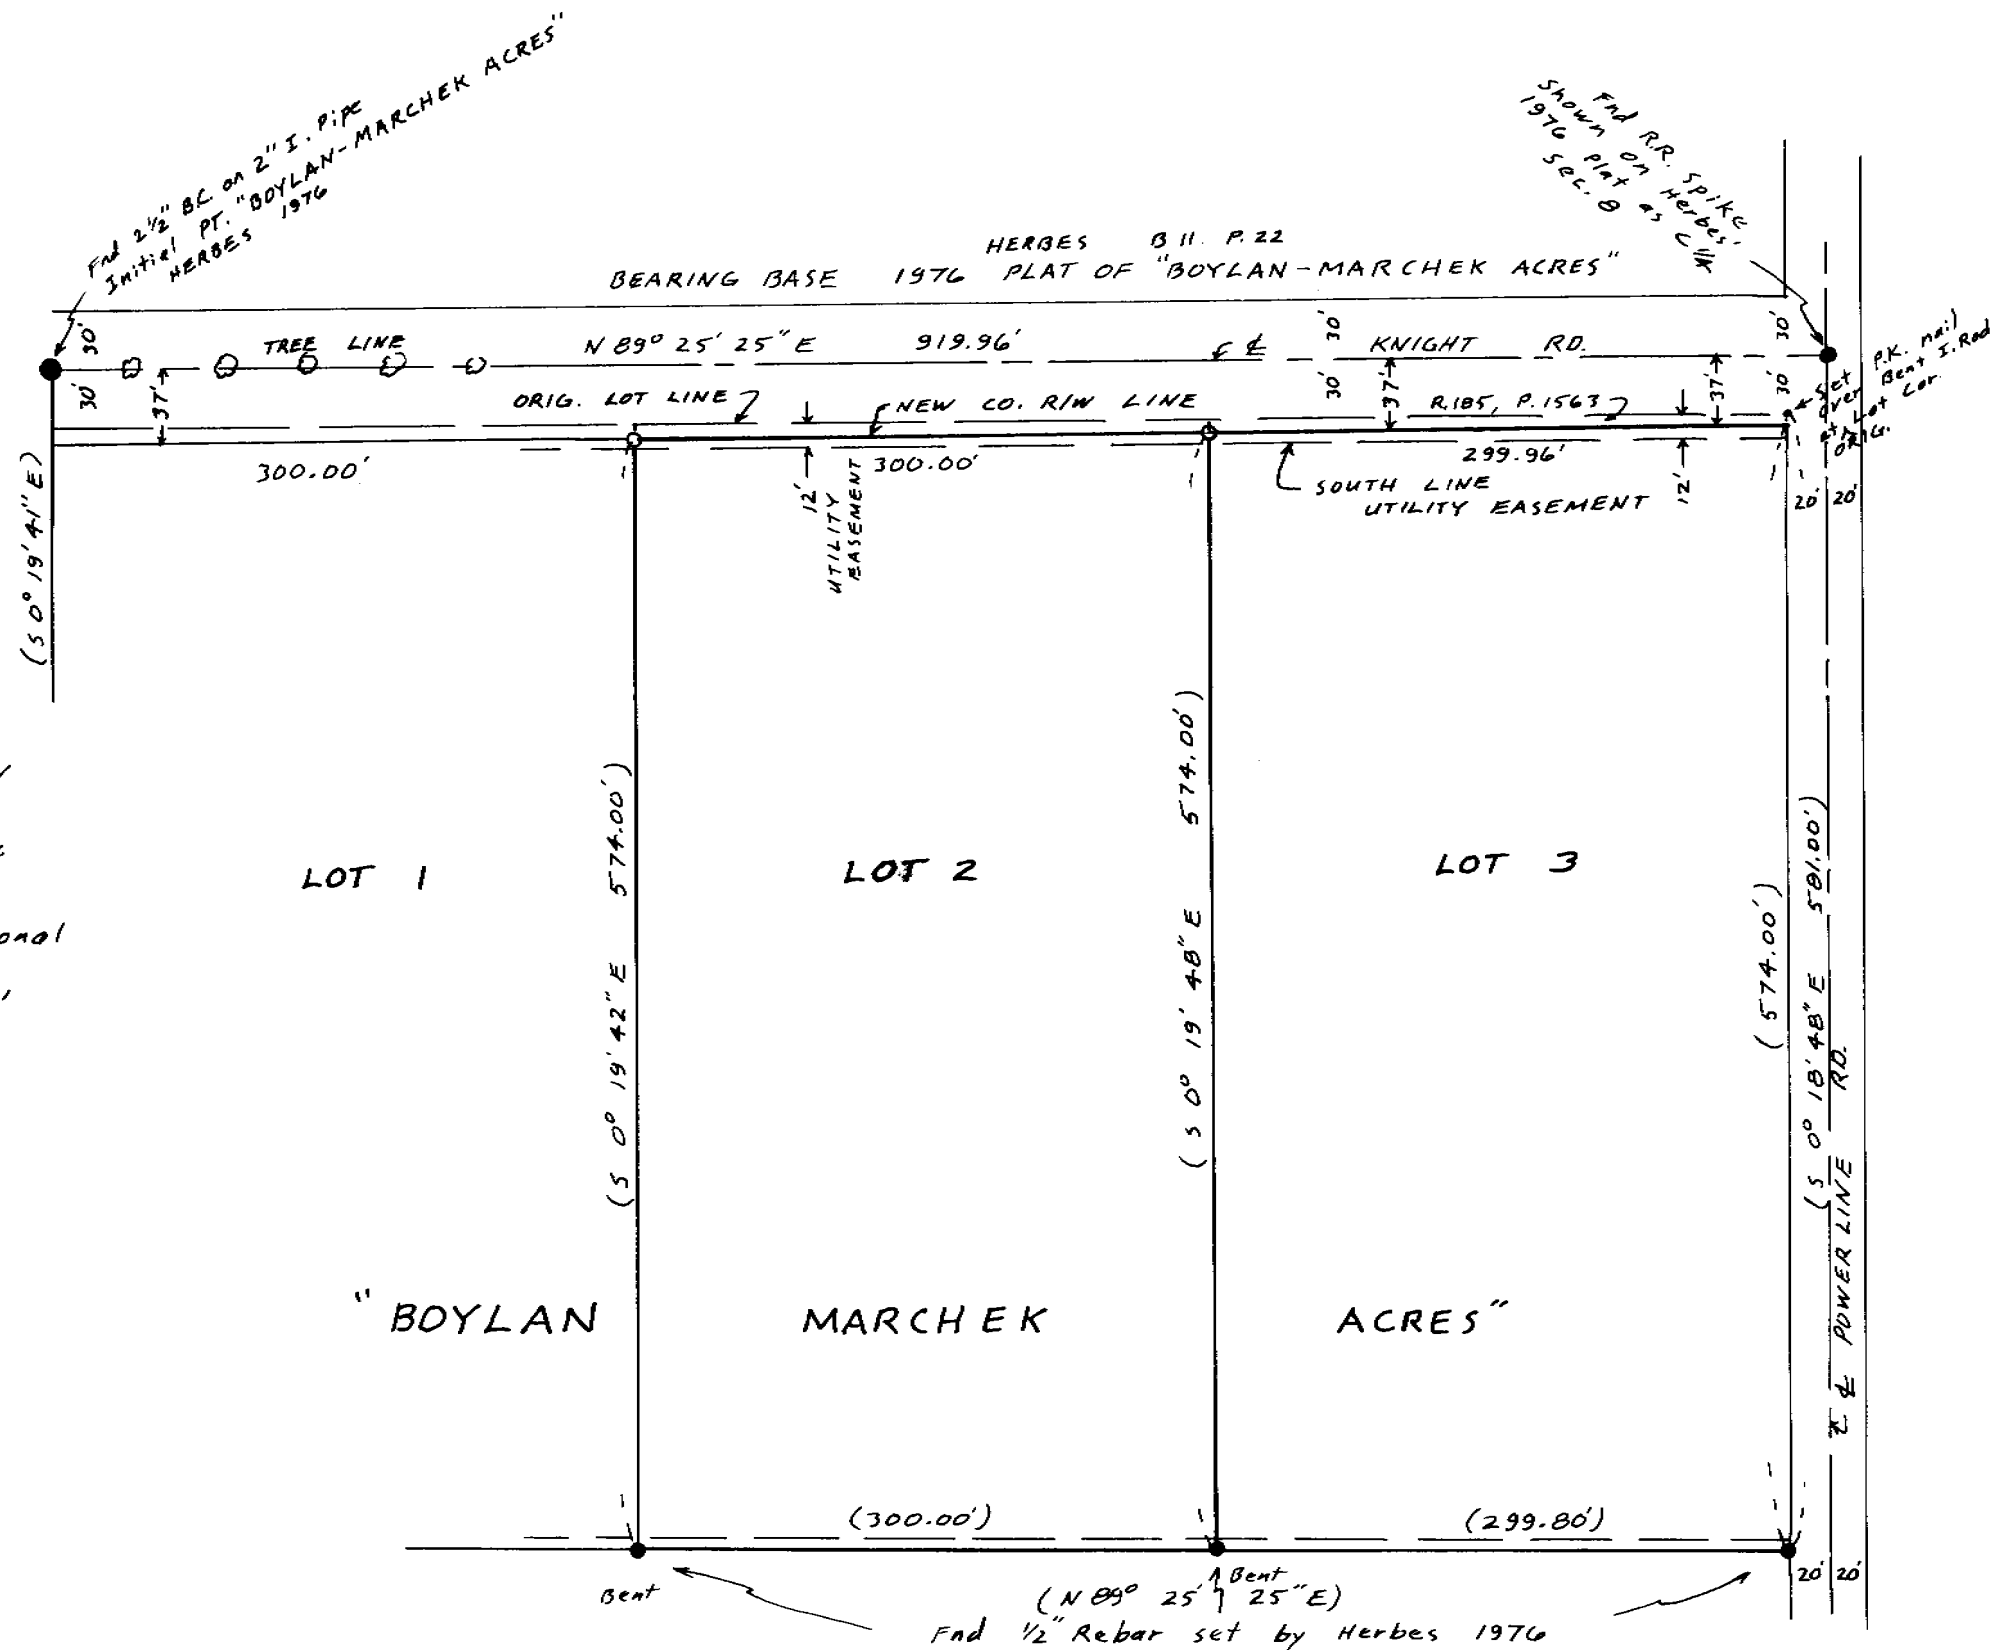

LOT 4

7-90 KA 90-51-A

90-51-A