


NARRATIVE:

The purpose of this survey is to stake an additional 25 acres adjacent to a 10 acre parcel so the property line can be adjusted to include all 35 acres. I surveyed the 10 acre parcel in 1989 for the Port of Umatilla and this survey and the bearings are based on it.

LEGEND:

- Monuments found.
- 1/2" x 24" rebar set with Alum. tag # 951.

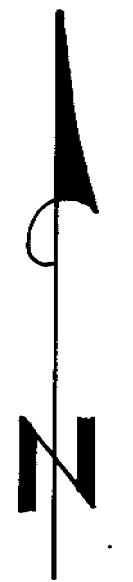

Scale: 1" = 200'

REGISTERED
PROFESSIONAL
LAND SURVEYOR

J. Dennis Edwards

OREGON
JULY 16, 1971
G. DENNIS EDWARDS
951

RECEIVED BY
Umatilla County Surveyor
Date 7-91
Rec'd By [Signature]
No. 91-55-A

SURVEY FOR THE PORT OF UMATILLA
In E 1/2 Sec. 14, T5N, R28E, W.M.
Umatilla County, Oregon
3/28/91 Job #58903013-A
Edwards Surveying P.O. Box 763
567-3336 Hermiston, Oregon 97838
REVISED 5/1/91

91-55-A