NARRATIVE:

The purpose of this survey is to stake the corners of Lot 16, Block 2, "Dixson Heights", excepting a pie shaped piece off of the NE corner so a chain link fence can be built. I surveyed the North line of said parcel in a 1979 survey for Winger.

LEGEND:

- ● 1/2" Iron rod found original 1952 Plat, unless otherwise noted.
- o 1/2" x 24" rebar set with Alum. tag #951.
- (ooo) of Record original 1952 Plat of "DIXSON HEIGHTS."

REGISTERED PROFESSIONAL LAND SURVEYOR
G. Dennis Edwards
OREGON
JULY 16, 1971
G. DENNIS EDWARDS
951

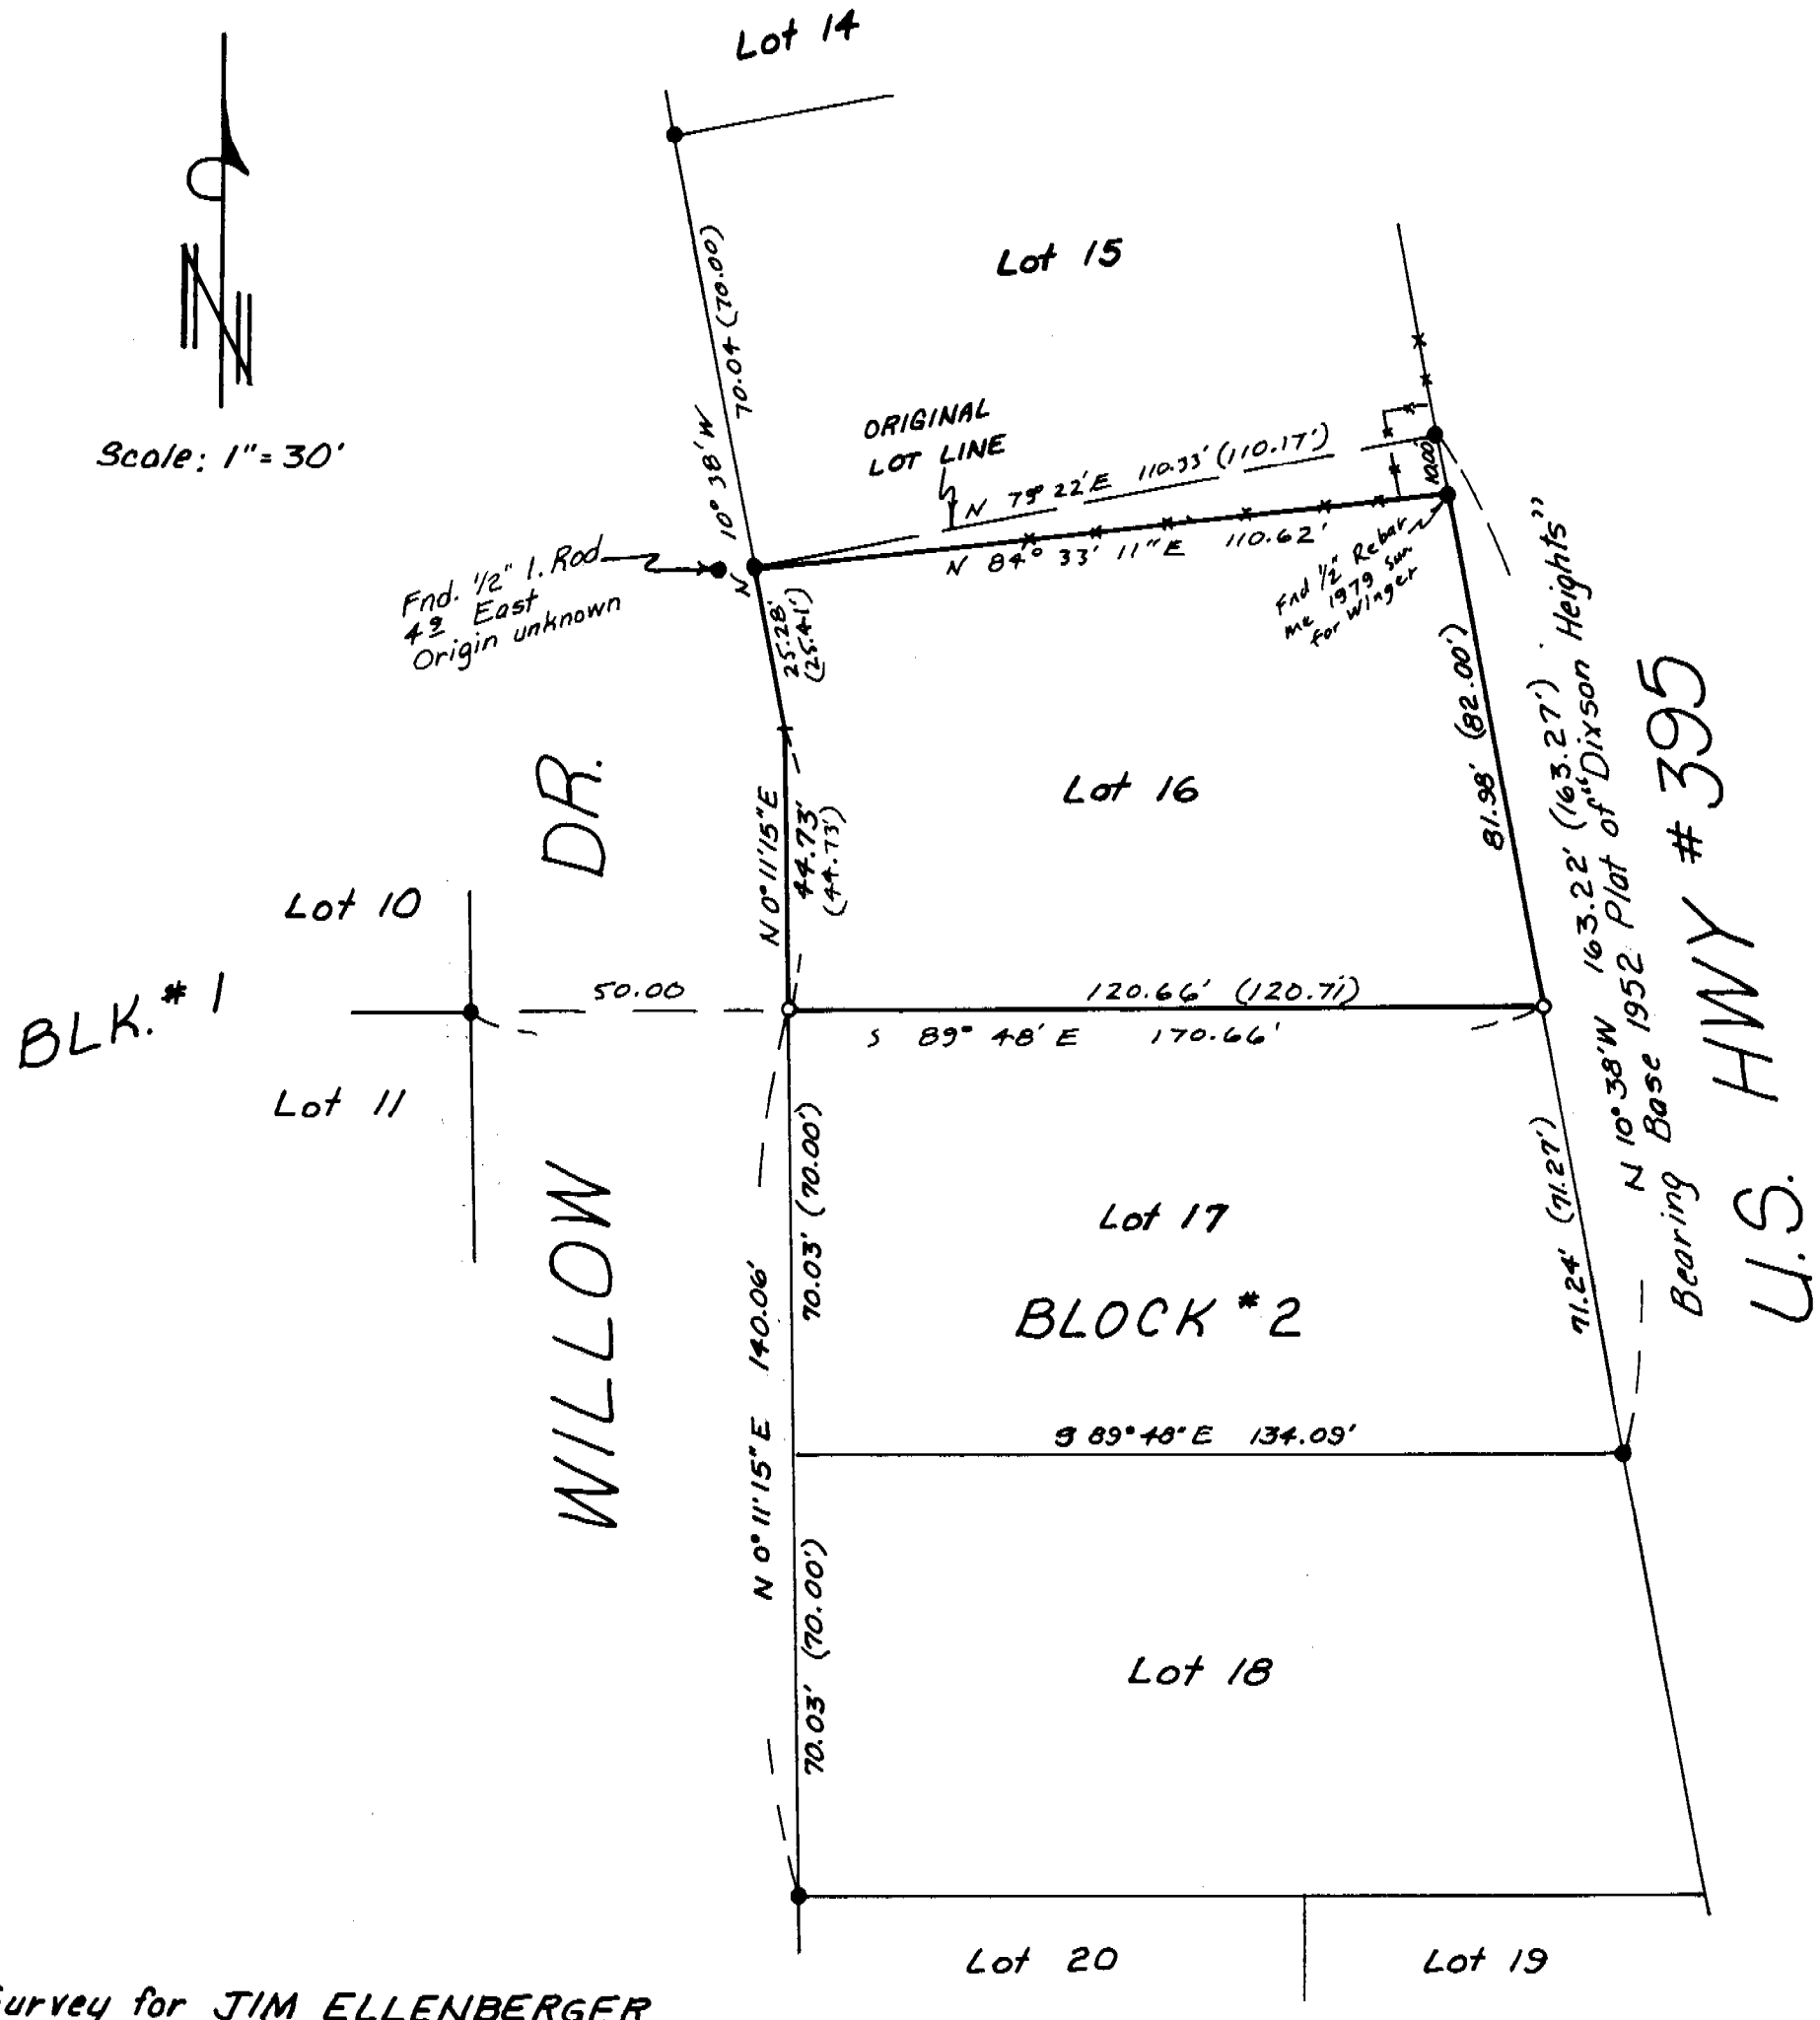

Survey for JIM ELLENBERGER
In Lot 16, Blk. 2, Dixson Heights,
City of Stanfield.
In NW 1/4 Sec. 32, T4N, R29E, W.M.,
Umatilla County, Oregon
9/26/91 Job # S9109045
Edwards Surveying P.O. Box 763
567-3336 Hermiston, Ore. 97838
91-100-A

RECEIVED BY
Umatilla County Surveyor
Date 12-9-91
Rec'd By KK
No. 91-100-A