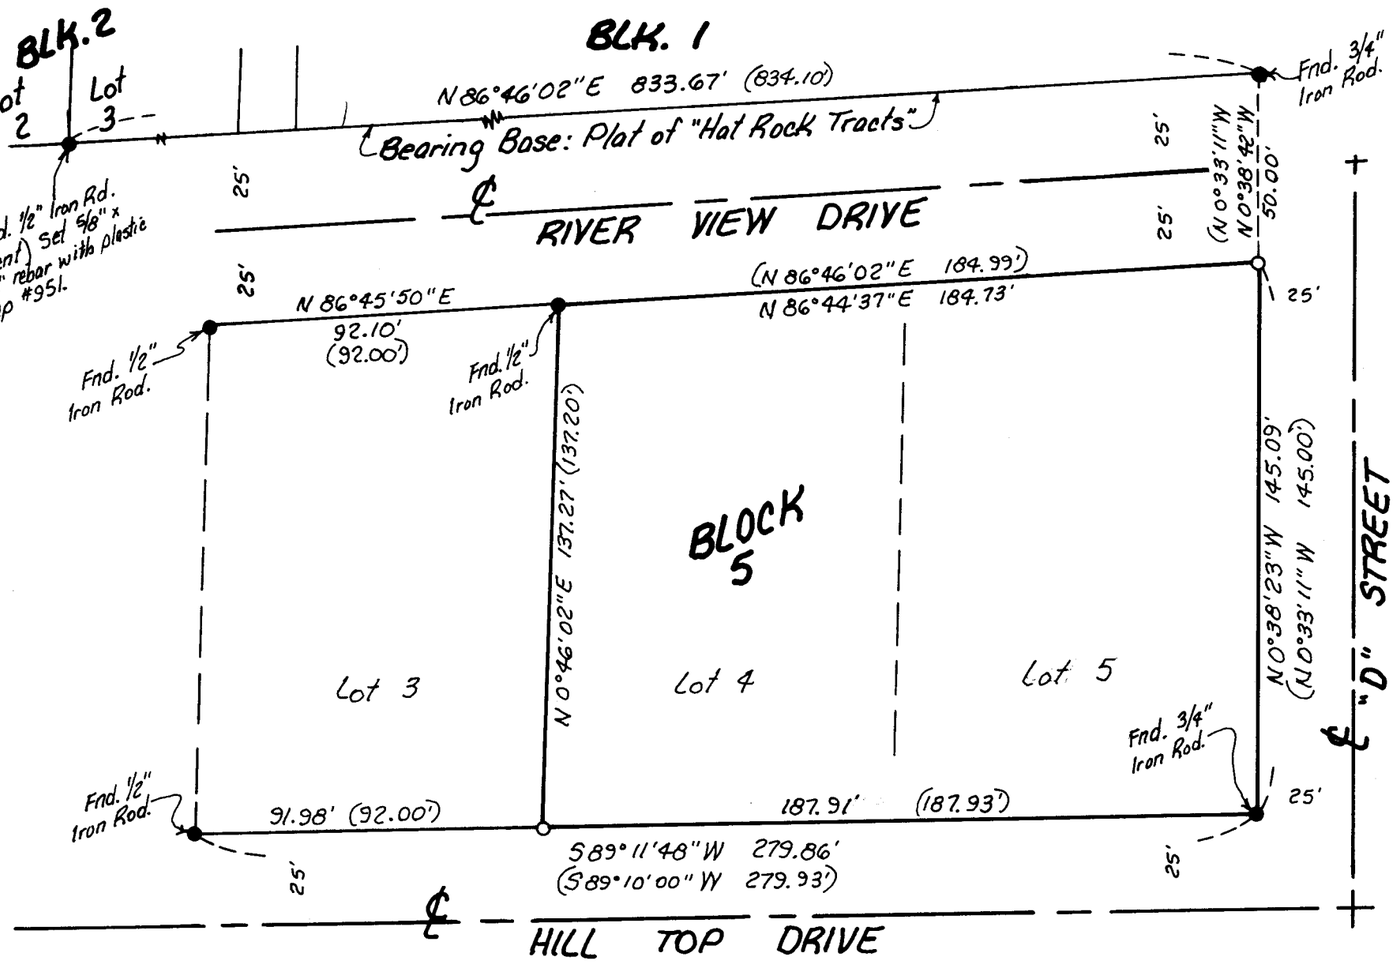

Scale: 1"=40'

NARRATIVE:

The purpose of this survey is to set the missing corners of the parcel, Lots 4 and 5, Block 5, "HAT ROCK TRACTS," so the setbacks to a new home can be determined. The monuments found were the original ones set by Ofner in the 1952 survey for "HAT ROCK TRACTS."

REGISTERED PROFESSIONAL LAND SURVEYOR
G. Dennis Edwards
OREGON
JULY 15, 1971
G. DENNIS EDWARDS
951

LEGEND:

- ● Found monuments, 1/2" or 3/4" I. Rod. Ofner, 1952.
- ○ Set 5/8" x 30" rebar with plastic cap #951.
- (000) of Record. Frank Ofner's Plat of "HAT ROCK TRACTS" in 1952.

RECEIVED BY
Umatilla County Surveyor
Date 10-94
Rec'd By KK
No. 94-142-A

Survey for KEN WILSON
In Block 5, "HAT ROCK TRACTS"
In NE 1/4, Section 15, T5N, R29E, W. M.,
Umatilla County, Oregon
4/29/94 Job #S9404050
Edwards Surveying P.O. Box 763
503-567-3336 Hermiston, Oregon 97838

94-142-A