


SURVEY OF E 1/2 NORTH LINE and NORTH 1/2 EAST LINE of NW 1/4 NE 1/4 SECTION 28, T4N.R.37E., W.M., UMATILLA COUNTY, OREGON

LEGEND:

- = Found 1" Iron Pipe/Brass Cap/Mound of Rocks and 5' Steel Post (C.S.# 93-64-C).
- = Set 5/8" I. Rebar/Plastic Cap No. LS 474
- = Property Line marked with 3' red stakes at approx. 200' intervals, florescent red flagging and line blazes painted red.
- () = Record data of C.S. No. N-65-B

BASIS of BEARINGS: Record (C.S. No. N-65-B) bearing of E 1/2 North line section 28.

SCALE: 1" = 400'

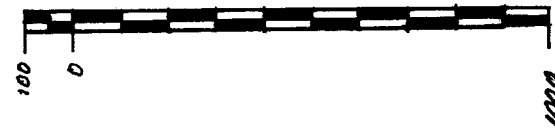

NARRATIVE:

The purpose of this survey was to establish the E 1/16 corner on the north line and the C-N-NE 1/64 corner of section 28 and to mark the south line of the E 1/2 SE 1/4 section 21 and also the north line and N 1/2 of the east line of the NW 1/4 NE 1/4 of subject 28.

The Boise Cascade survey (N-65-B) dated 2-5-77 was utilized for control for calculating the position of the 1/64 and 1/16 corners being that their measurement on the north section line matched mine exceptionally well.

I searched but found no trace of a 1/16 or 1/64 corner in the vicinity of the corners established here-in even though the old blazed lines cornered at my 1/64 corner.

The survey was run with a PENTAX EDM.

SURVEYED FOR: Jim Yandell

280 NE Liberty, Gresham, Or. 97030
Ph.: 503) 665-7519

SURVEYED BY: Philip J. Larson

307 SE 12th Ave., Milton-Freewater, Or. 97862
Ph. 503) 938-4727

DESCRIPTION OF CORNERS

E 1/16 COR. N. LINE

Set 5/8" I.R./P.C. from which:

A 10" White Fir scribed, "S28 BT" | 20d N'l. S/s & 6" red band br's. 557°E, 14.63'

A 7" White Fir scribed, "X BT" | 20d N'l. N/s & 6" red band br's. 588°W, 16.77'

C-N-NE 1/64 CORNER

Set 5/8" I.R./P.C. from which:

An 8" White Fir scribed, "X BT" | 20d N'l. N/s & 6" red band br's. 589°W, 12.90'

A 10" White Fir scribed, "BT" | 20d N'l. W/s & 6" red band br's. N04°E, 2.70'

DEED REF.: 236-464

C.S.# N-65-B

REGISTERED
PROFESSIONAL
LAND SURVEYOR

Philip J. Larson

OREGON
MAY 8, 1969
PHILIP J. LARSON
474

RECEIVED BY

Umatilla County Surveyor

Date 10-95

Rec'd by KK

No. 95-164-A

Expires 12-31-96

95-164-A