NARRATIVE:

The purpose of this survey is to correct the location of the South 1/4 Corner of Section 7 which was set wrong by Me in a 1994 survey for Ketchersid and to correct the three corners which I set using the incorrect 1/4 corner. All corners move approximately 1 foot Northwesterly.

I discovered this error in my Partition Plat survey for Jim Kooch (in progress) in which I retraced a 1978 survey for Kooch in which a one inch Iron Bar was at the 1/4 corner but had since been obliterated.

This survey is to replace my 1994 survey for Ketchersid (County #94-42-B).

His original intent was to build a new fence

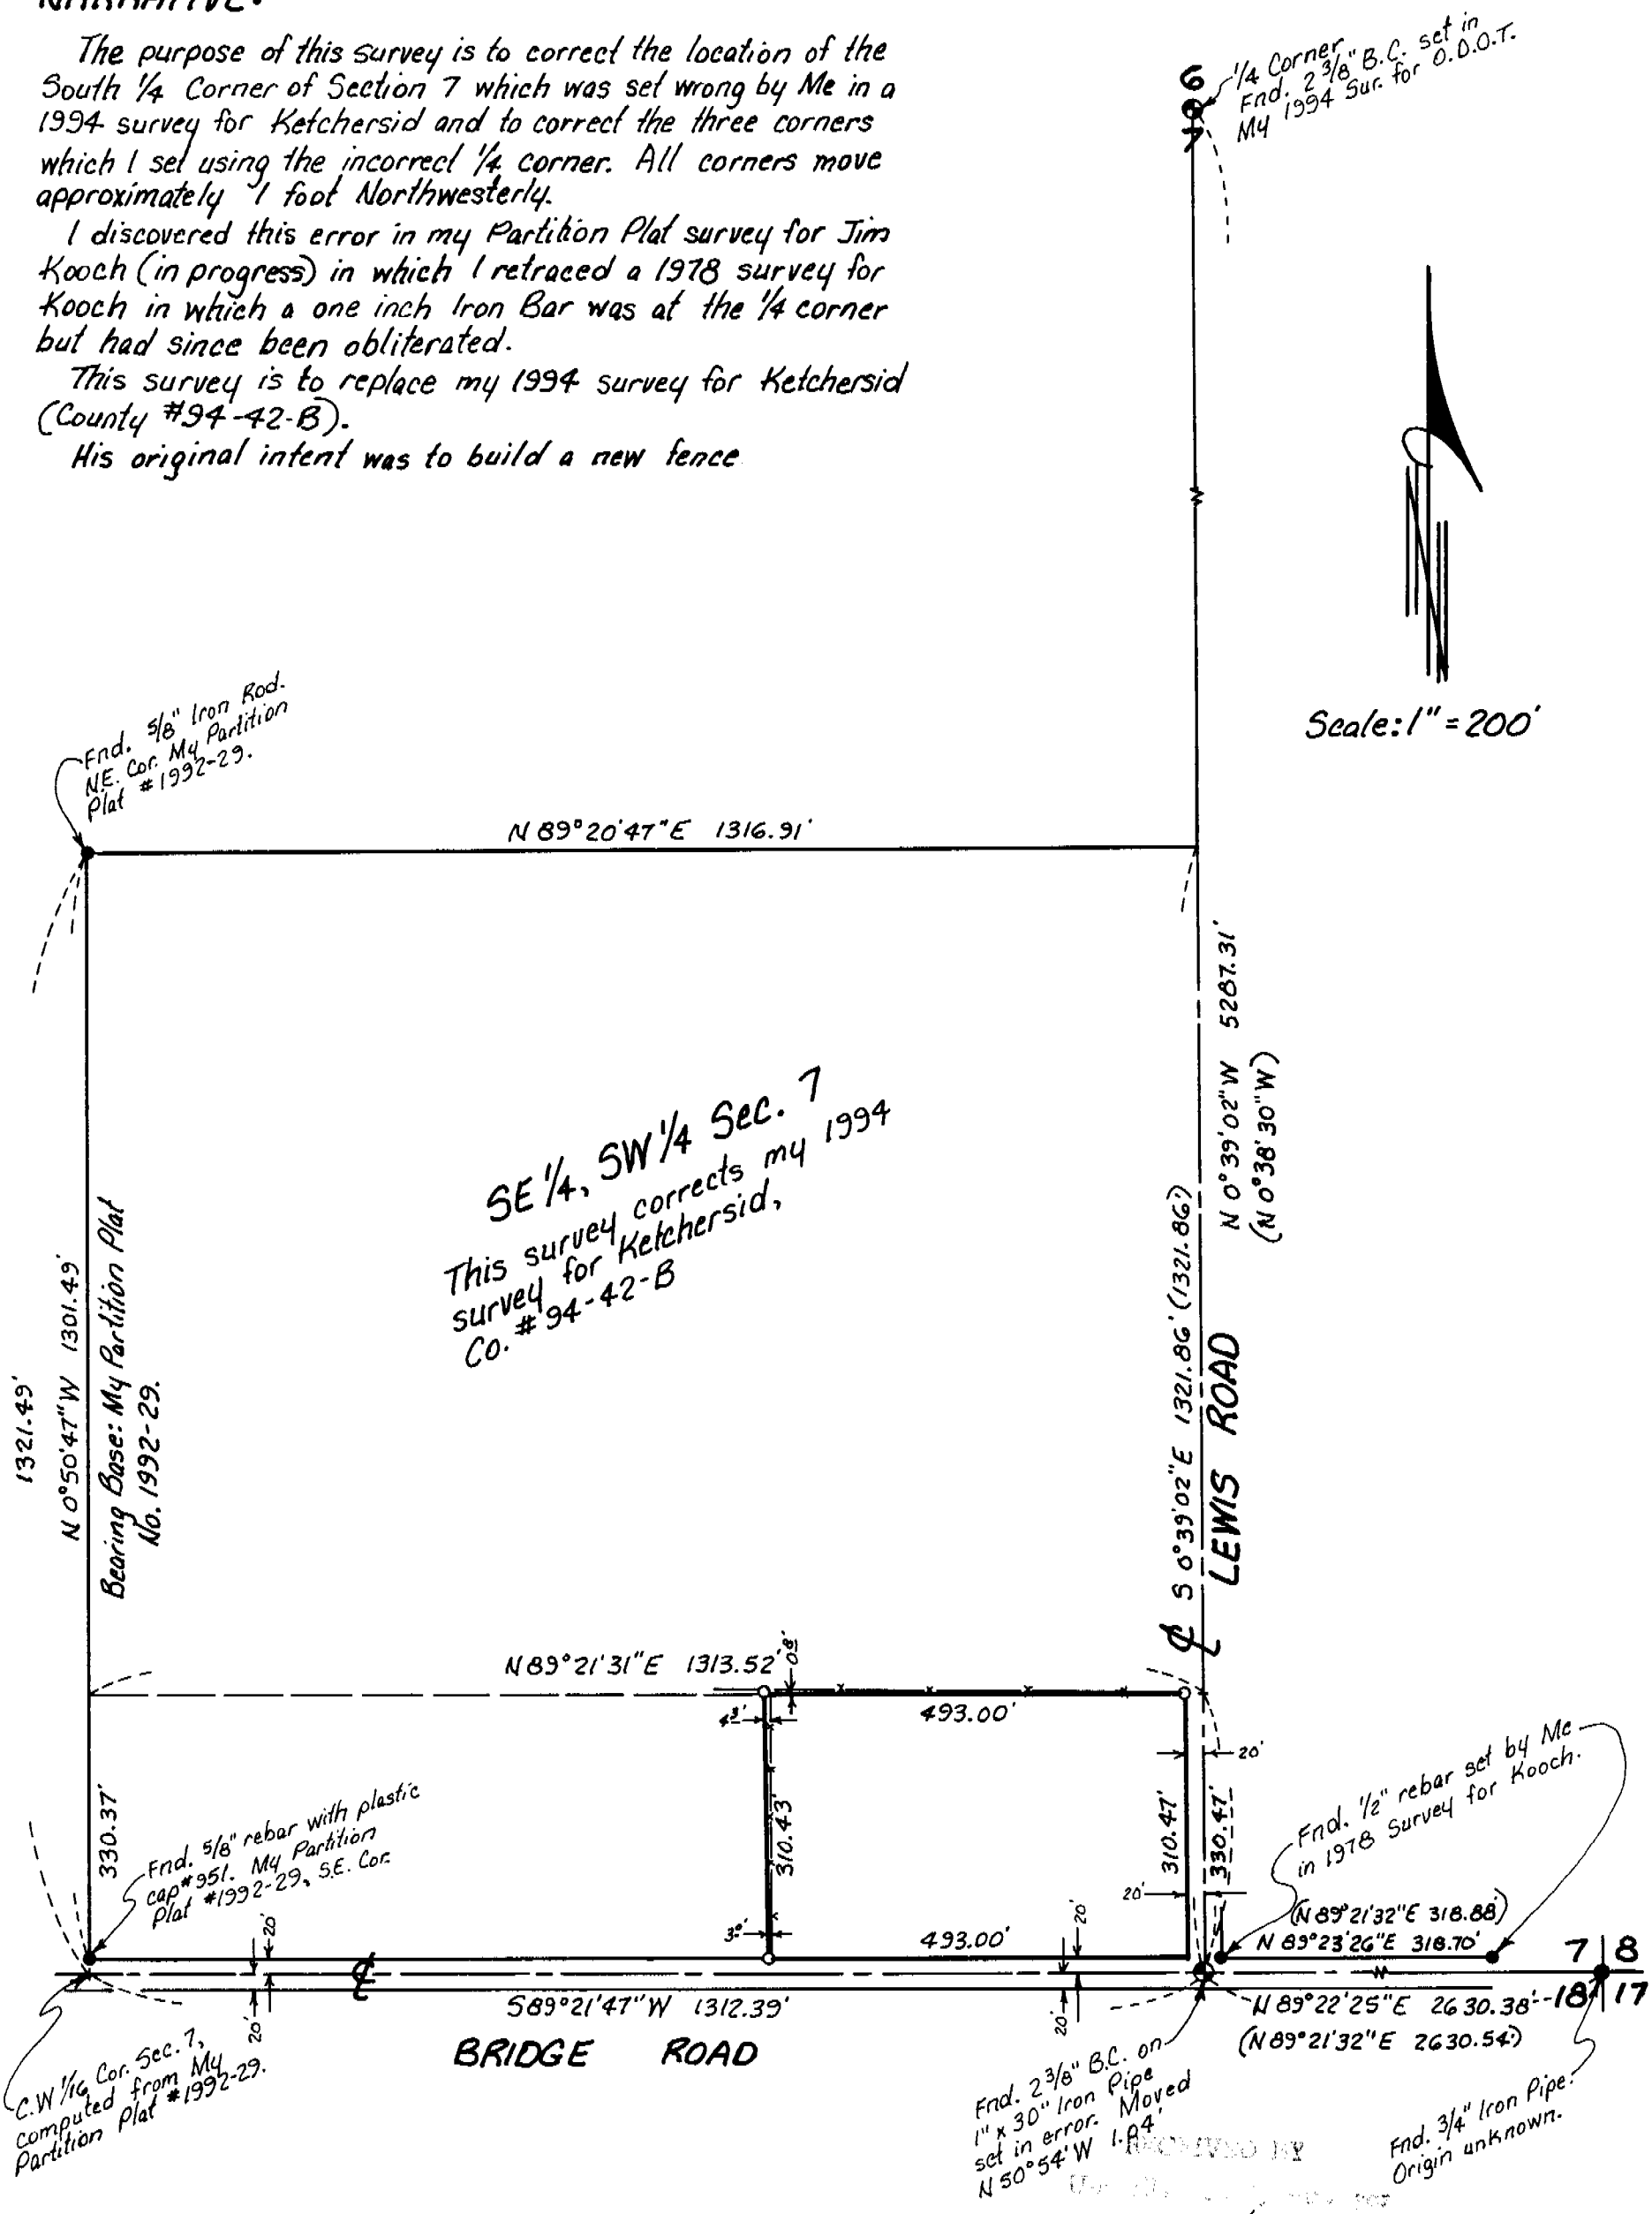

LEGEND:

- ● Found monuments, as noted.
- ○ Set 5/8" x 30" rebar with plastic cap #951.
- (ooo) of Record. My 1978 Survey for Jim Kooch.

RECORDED BY
3-96
KK
No. 96-40-A

Survey for QUENTIN KETCHERSID
In SW 1/4 Section 7, T4N, R28E, W.M.,
Umatilla County, Oregon
12/7/95 Job #S9403037-A
Edwards Surveying P.O. Box 763
541-567-3336 Hermiston, Oregon 97838

96-40-A