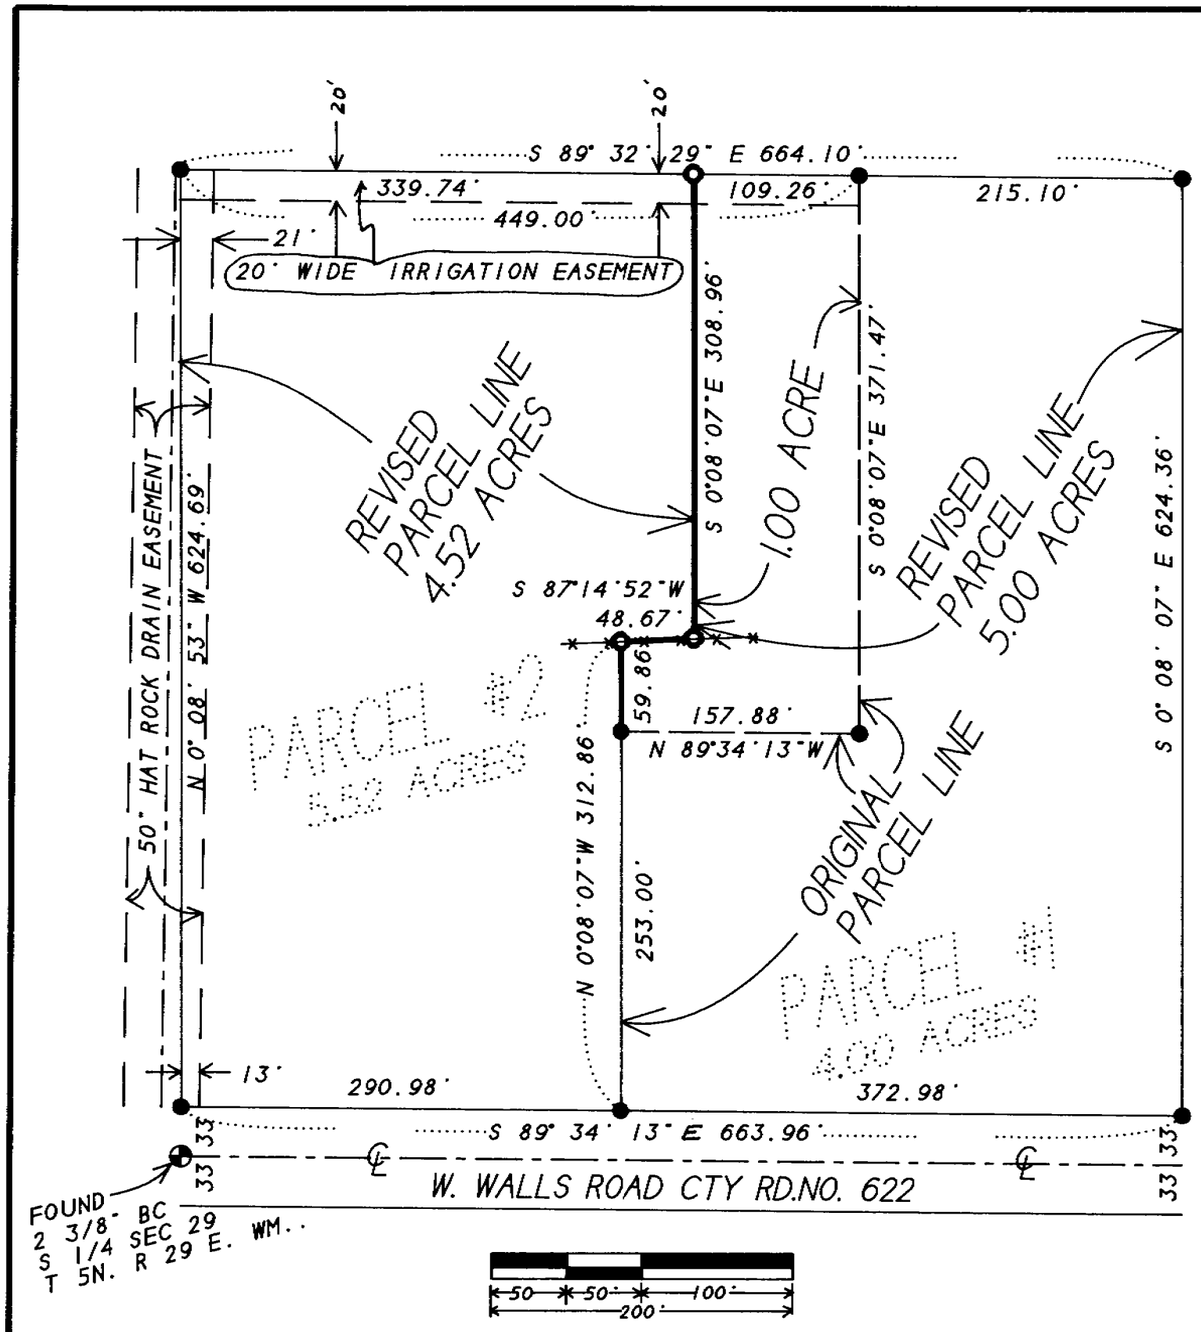

BOUNDARY LINE ADJUSTMENT LOCATED IN UMATILLA COUNTY PARTITION PLAT # 1994-20 WHICH IS LOCATED IN THE SE 1/4 OF SECTION 29. T 5 N. R 29 E. WM. UMATILLA COUNTY. OREGON.

SURVEYOR'S NARRATIVE:

THE PURPOSE OF THIS SURVEY IS TO DO A BOUNDARY LINE ADJUSTMENT TO TRANSFER 1.00 ACRE OF PARCEL # 2 TO PARCEL # 1. PARTITION PLAT # 1994-20. I SURVEYED THIS PARTITION IN MARCH 1994 FOR ROXANNE SALSBERY. THE BEARINGS AND THIS SURVEY ARE BASED ON THAT 1994 PARTITION PLAT SURVEY.

SCALE 1"=100'

LEGEND:

- ● FOUND 5/8" REBAR WITH PLASTIC CAP #951. 1994-20 PARTITION PLAT. BY ME
- ○ SET 5/8" REBAR WITH PLASTIC CAP # 951 30" LONG

REGISTERED PROFESSIONAL LAND SURVEYOR

G. Dennis Edwards

OREGON JULY 16, 1971 G. DENNIS EDWARDS 951

RENEWS 12/31/95

3-96

KK

No. 96-43-A

BOUNDARY LINE ADJUSTMENT FOR:

SALSBERY AND VAUGHN

LOCATED IN THE SE 1/4. SEC 29. T5N.R29E.WM.. UMATILLA COUNTY. OREGON

12/26/95 JOB NO. S9402019-A

EDWARDS SURVEYING PO BOX 763

HERMISTON. OR 97838 541-567-3336

96-43-A