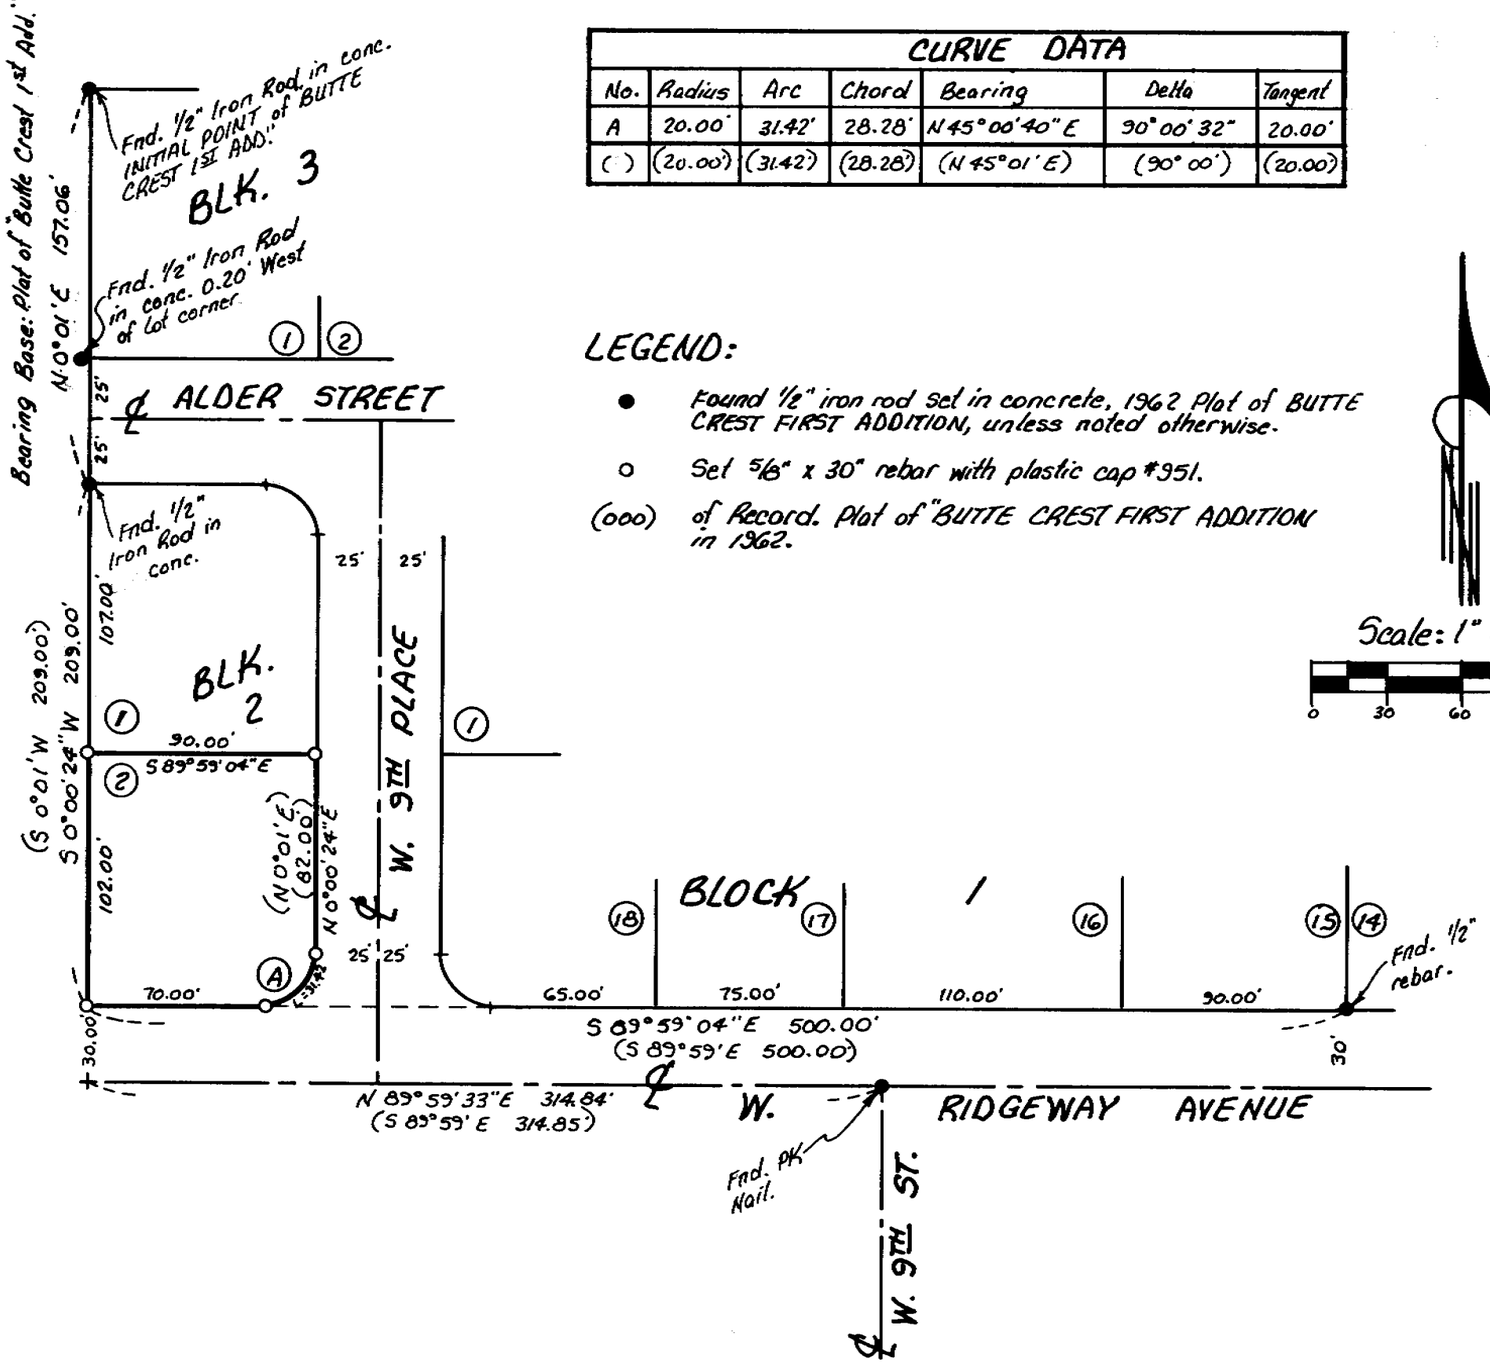

CURVE DATA						
No.	Radius	Arc	Chord	Bearing	Delta	Tangent
A	20.00'	31.42'	28.28'	N 45°00'40" E	90°00'32"	20.00'
( )	(20.00')	(31.42')	(28.28')	(N 45°01' E)	(90°00')	(20.00')

LEGEND:

- ● Found 1/2" iron rod set in concrete, 1962 Plat of BUTTE CREST FIRST ADDITION, unless noted otherwise.
- o Set 5/8" x 30" rebar with plastic cap #951.
- (000) of Record. Plat of "BUTTE CREST FIRST ADDITION in 1962.

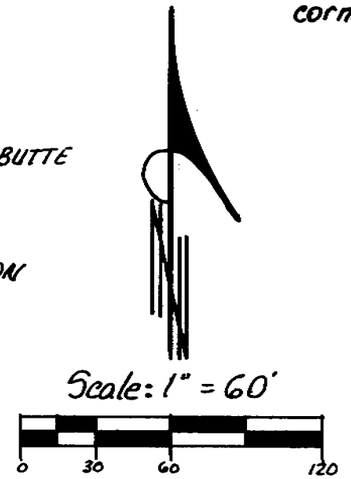

NARRATIVE:

The purpose of this survey is to set the missing corners of lot 2, Block 2, "BUTTE CREST FIRST ADDITION," so a new home can be sited at the proper setbacks.

I retraced the original 1962 Plat from monuments found North and East of said lot 2 to establish the missing corners.

REGISTERED PROFESSIONAL LAND SURVEYOR
G. Dennis Edwards
OREGON
JULY 16, 1971
G. DENNIS EDWARDS
951
RENEWS 12/31/97

RECEIVED BY
Umatilla County Surveyor
Date 5-97
Rec'd By KK
No. 97-92-A

Survey for DICK MAXWELL
In Lot 1, & 2, Block 2, "BUTTE CREST FIRST ADD."
Hermiston, Umatilla County, Oregon
In S ½, NW ¼ Section 10, T4N, R28E, W.M..
4/7/97 Job #S9704066
Edwards Surveying P.O. Box 763
541-567-3336 Hermiston, Oregon 97838

97-92-A