


LEGEND:

- Found 5/8" rebar:
 - Ⓚ Krumbein, 1972 Sur. for Sawyer.
 - ⓔ My 1994 Survey for Kennedy.
- Found 2 1/2" Brass Cap (50.9') South of C 1/4 Cor. Krumbein, 1974 survey for Sawyer.
- Set 5/8" x 30" rebar with plastic cap #951.
- (000) of Record. 1972 survey by Krumbein for Sawyer.
- [000] of Record. Contract Book 325, Page 541.

- L1 N 78°29'26" E 25.50'
- L2 N 89°57'00" E 25.00'
- L3 S 89°40'46" W 25.04'
- L4 N 86°43'39" W 39.91'

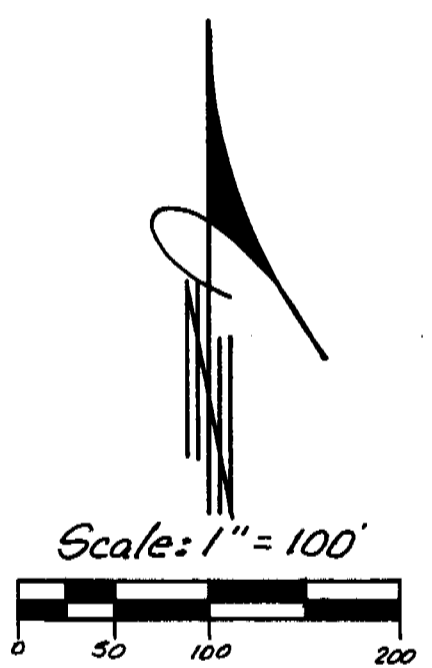

NARRATIVE:

The purpose of this survey is to replace a survey monument which Cascade Natural Gas dug out at the NE corner of that tract of land decided to Daniel Shumaker, et ux, recorded on Reel 311, Page 1575, Umatilla County Deed Records. Said monument was set by Dave Krumbein in a 1972 survey for Helen Sawyer.

I retraced Krumbein's survey to set the missing corner.

The distance from the Brass Cap on the N-S centerline of the section to Shumaker's NW corner is what Shumaker's deed says but Krumbein's map says it is 16 feet farther.

Another purpose of this survey is to stake a portion of a 25 foot easement as described in a deed to J. Nelson Kennedy, et ux, as recorded on Reel 101, Page 1867, Umatilla County Deed Records.

REGISTERED PROFESSIONAL LAND SURVEYOR

G. Dennis Edwards

OREGON
JULY 16, 1971
G. DENNIS EDWARDS
951
RENEWS 12/31/97

RECEIVED BY
Umatilla County Surveyor
Date 11-97
Rec'd By KK
No. 97-204-A

Survey for CASCADE NAT. GAS & LARRY GREENAWALT
in SW 1/4 of Section 18, T5N, R28E, W. M.,
Umatilla County, Oregon
10/15/97
Edwards Surveying
541-567-3336
Job #59710239
P.O. Box 763
Hermiston, Oregon 97838