

**NARRATIVE:**

The purpose of this survey is to set the corners of that tract of land deeded to Vonna Grotz on Reel 319, Page 225, Umatilla County Deed Records, so trees can be planted along the West line.

The South line of this parcel is 50 feet Northerly of the centerline of the U.S.R.S. Feed Canal, the East line is the Westerly R/W of Canal Road, the North line is the Southerly R/W of Loop Road and the West line is parallel with the East line.

I established the South line from ties to the centerline of the canal. I established the North line from monuments from my 1978 survey for Peck to the North. I established the East and West lines from my 1992-1 County Monumentation survey. The East line of this parcel differs from the East line of Peck's by about 4 feet because the Northeast corner of Section 7 which Harris set in 1968 lies about 7.5 feet West of one which Cramer found in 1986. Cramer's corner has been determined to be the better location for said Section Corner.

REGISTERED  
PROFESSIONAL  
LAND SURVEYOR


*G. Dennis Edwards*

OREGON  
JULY 16, 1971  
G. DENNIS EDWARDS  
951  
RENEWS 12/31/99

**LEGEND:**

- Found monuments, as noted.
- Set 3/8" x 30" rebar with plastic cap #951.
- (ooo) of Record. My 1978 survey for Peck.
- [ooo] of Record. DEED, Reel 319, Page 225.

Scale: 1" = 60'

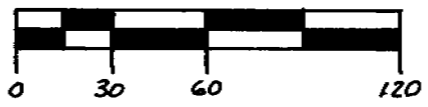

RECEIVED BY  
Umatilla County Surveyor  
Date 5-98  
Rec'd By KK  
No. 98-87-A

Survey for VONNA GROTZ  
In the E 1/2 of Section 7, T4N, R29E, W.M.,  
Umatilla County, Oregon  
3/17/98 Job #59803060  
Edwards Surveying P.O. Box 763  
541-567-3336 Hermiston, Oregon 97838

28-87-A