

**LEGEND:**

- FOUND 5/8" IRON REBAR SET BY ROBERTS IN 1998 SURVEY FOR UMATILLA COUNTY ROAD DEPT.
- FOUND 1/2" IRON REBAR ROBBETT 1947 PLAT OF "CARELLE ADDITION"
- SET 5/8"x30" IRON REBAR WITH PLASTIC CAP #951
- EP-- EDGE OF PAVEMENT

**NARRATIVE:**

THE PURPOSE OF THIS SURVEY IS TO DESCRIBE TWO STREET RIGHTS OF WAY WHICH RUN FROM TUCKER AND STEPHENS AVENUES TO POWER LINE ROAD.

I BASED THE BEARINGS OF THIS SURVEY ON ONE DONE BY ROBERTS FOR UMATILLA COUNTY FOR THE ALIGNMENT OF POWER LINE ROAD.

REGISTERED  
PROFESSIONAL  
LAND SURVEYOR


*G. Dennis Edwards*

OREGON  
JULY 16, 1971  
G. DENNIS EDWARDS  
9 5 1  
RENEWS 12/31/2003

RECEIVED BY

Umatilla County Surveyor

Date 11-02  
Rec'd By KK  
No. 02-259-A

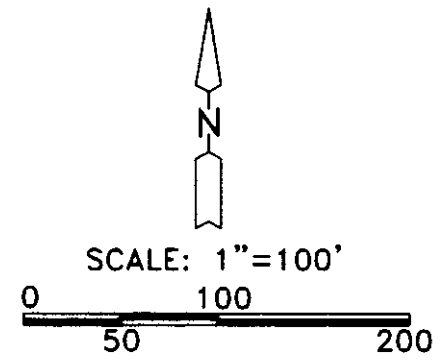

SURVEY FOR CITY OF UMATILLA  
IN SW 1/4, SEC. 17, T 5 N, R 28 E, W.M.,  
UMATILLA COUNTY, OREGON  
8/29/2002 JOB# S0208171  
EDWARDS SURVEYING P.O. BOX 763  
541-567-3336 HERMISTON, OREGON 97838  
DRAWN BY NJF

02-259-A