




Fnd. 3" I. Pipe


Fnd 3/4" I. Pipe

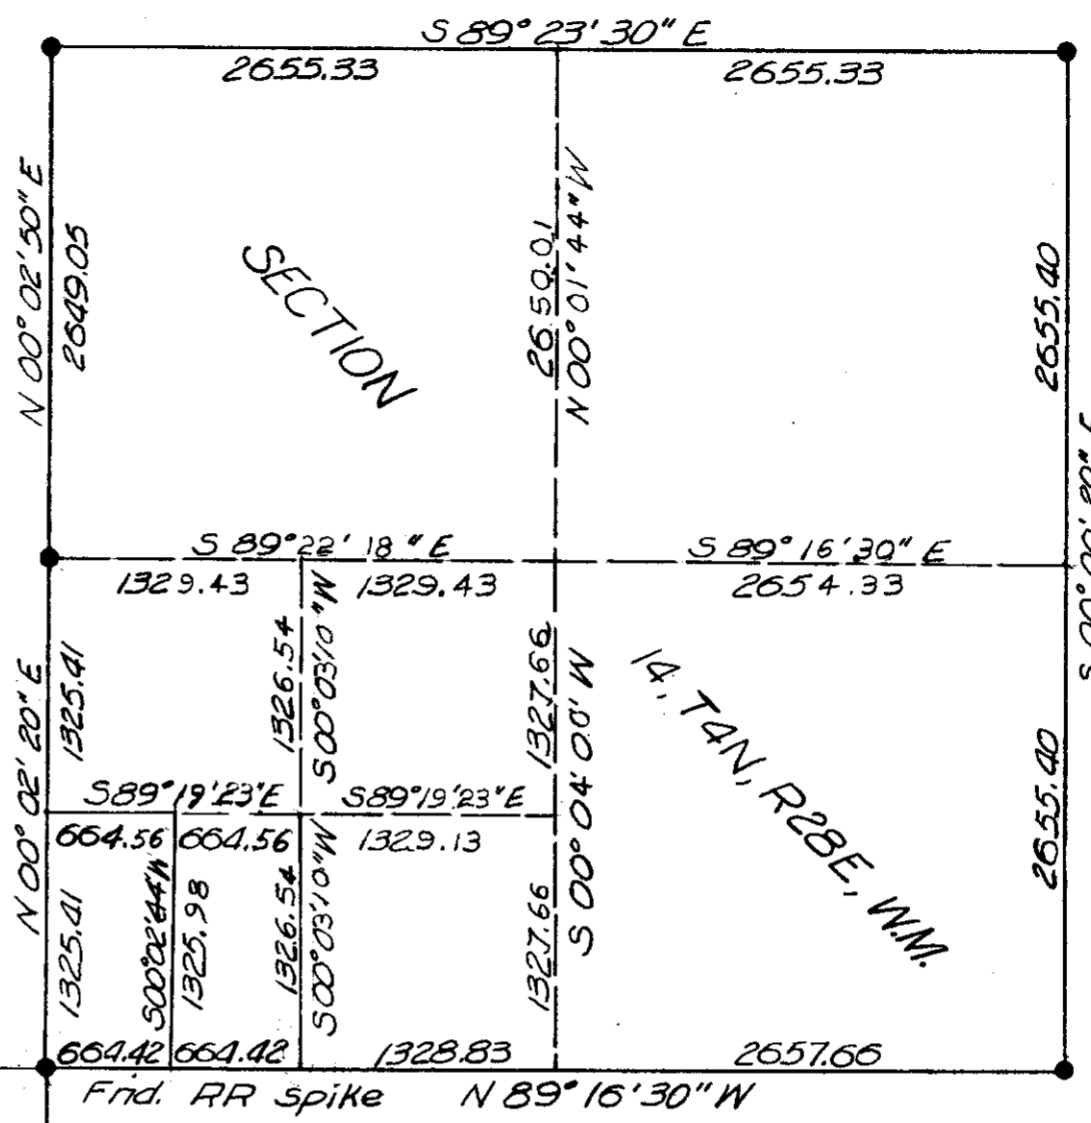


Fnd. Brass cap

Fnd Brass cap

Unable to locate corner, used previous ties.

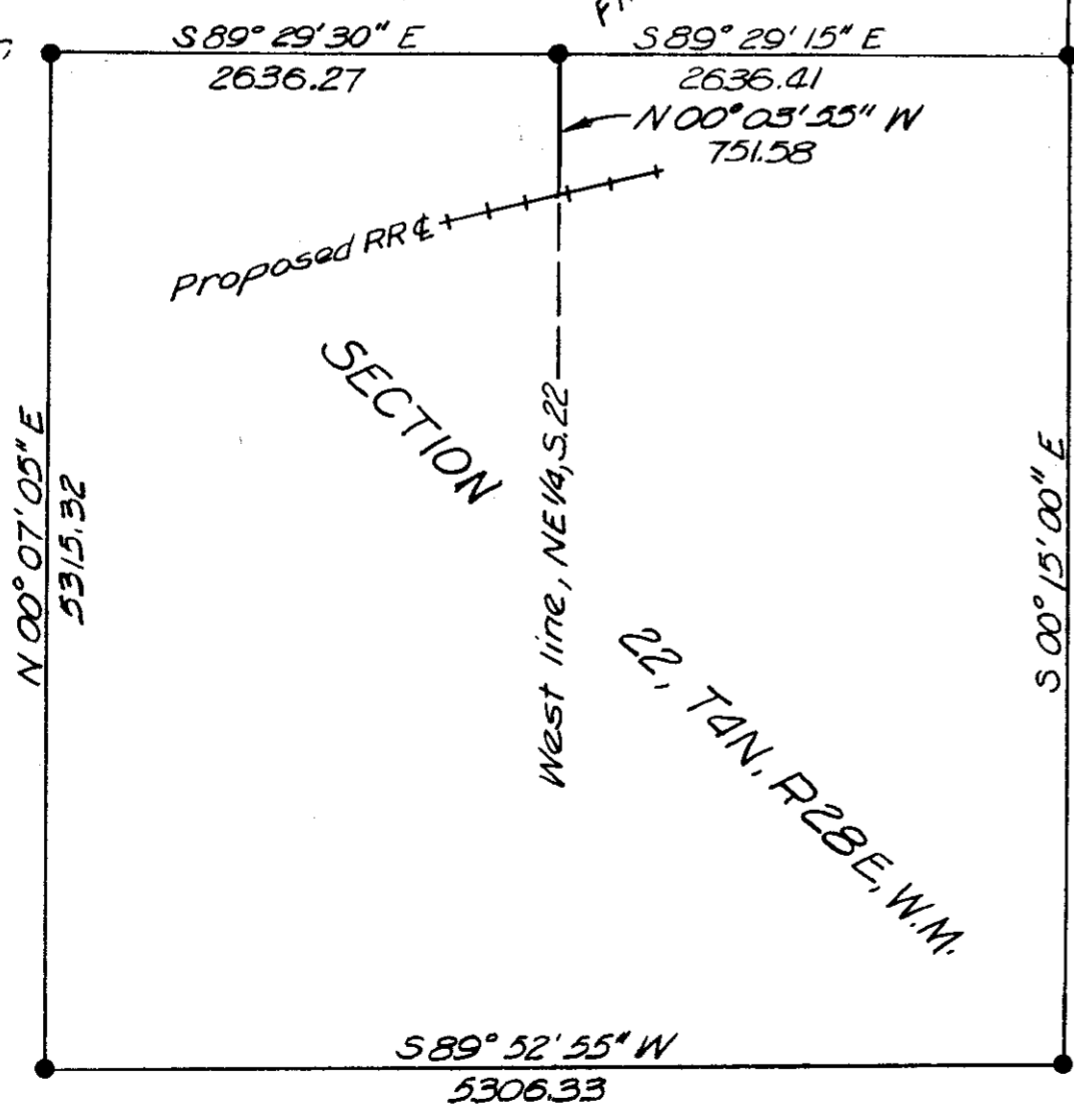

Bearings are based on ties to USC & GS station "HERMISTON".

 

03-181-A

03-181-A

SURVEY FOR		WAYNE HARRIS CO INC			
UPLAND INDUSTRIES		ENGINEERS SURVEYORS			
IN SECTIONS		PENDLETON, OR			
22 AND 14, T4N, R28E WM		SCALE	DRG BY	JHB	DRNG NO
		DATE	6-19-75	GKD BY	DHK 75-338A