


NOTE: BEARINGS SHOWN ARE TRUE BEARINGS AND ARE BASED ON N.O.S. STATION "HERMISTON"

- LEGEND:
- DENOTES POINTS FOUND DURING THIS SURVEY
 - DENOTES 1/2" IRON PINS SET DURING THIS SURVEY
 - () DENOTES RECORDED INFORMATION AS FILED WITH THE UMATILLA COUNTY SURVEYOR

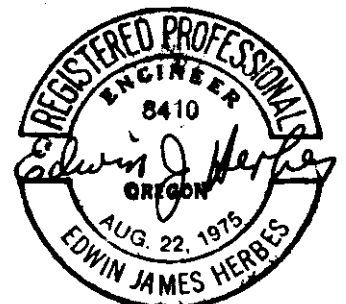

03-322-A

SURVEY IN NW 1/4 SEC 10		WAYNE HARRIS CO. INC.			
T4N R28E		ENGINEERS - SURVEYORS		PENDLETON, ORE.	
SCALE	DATE	DRN. BY	CHK. BY	DRN. NO.	
1"=200'	2-17-76	JH	CTP	76-375A	

76-145

03-322-A