

**NARRATIVE:**

THE PURPOSE OF THIS SURVEY IS TO STAKE LOTS 1 AND 2, BLOCK 2, "DEMOSS HOMESTEAD SUBDIVISION" SO THEY CAN BE SOLD SEPARATELY.


I RETRACED LAGIER'S 1979 PLAT TO SET THE THREE MISSING CORNERS OF THESE TWO LOTS. THE SOUTHWEST CORNER OF LOT 1 FALLS IN A FENCE POST SO A WITNESS CORNER WAS SET 0.3 FOOT SOUTH.

THE BEARINGS ARE BASED ON THE 1979 PLAT OF "DEMOSS HOMESTEAD SUBDIVISION".


REGISTERED  
PROFESSIONAL  
LAND SURVEYOR

*G. Dennis Edwards*

OREGON  
JULY 16, 1971  
G. DENNIS EDWARDS  
9 5 1  
RENEWS 12/31/2005

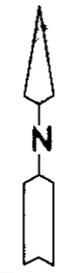

SCALE: 1" = 100'

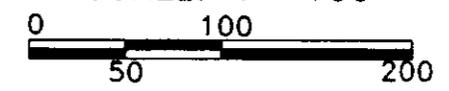

RECEIVED BY

Umatilla County Surveyor

Date 2-05

Rec'd By KK

No. 05-37-A

SURVEY FOR SCOTT JOHNSON  
IN LOTS 1 & 2, BLK. 2 OF "DEMOSS HOMESTEAD SUBDIVISION",  
IN SE 1/4, SEC. 29, T 5 N, R 29 E, W.M.,  
UMATILLA COUNTY, OREGON  
1/30/05 JOB #S0501018  
EDWARDS SURVEYING P.O. BOX 763  
541-567-3336 HERMISTON, OREGON 97838  
DRAWN BY NJF