

**NARRATIVE:**


THE PURPOSE OF THIS SURVEY IS TO DO A BOUNDARY LINE ADJUSTMENT TO ADD TWO FEET OF LOT 10 TO LOT 9. I RETRACED THE PLAT OF "HIGHLAND VISTA SUBDIVISION, PHASE TWO" TO ESTABLISH THE ORIGINAL AND THE NEW BOUNDARY LINES.

**REVISED DESCRIPTION OF LOT 9**


LOT NINE "HIGHLAND VISTA SUBDIVISION, PHASE TWO" CITY OF HERMISTON, UMATILLA COUNTY, OREGON. ALSO THE WEST 2.00 FEET OF LOT 10 OF SAID "HIGHLAND VISTA SUBDIVISION, PHASE TWO".

**REVISED DESCRIPTION FOR LOT 10**

LOT 10 "HIGHLAND VISTA SUBDIVISION, PHASE TWO", CITY OF HERMISTON, UMATILLA COUNTY, OREGON. EXCEPTING THEREFROM THE WEST 2.00 FEET THEREOF.

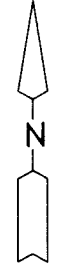

SCALE: 1"=20'

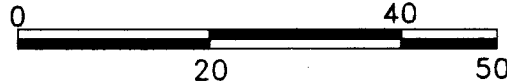

REGISTERED  
PROFESSIONAL  
LAND SURVEYOR

*G. Dennis Edwards*

OREGON  
JULY 16, 1971  
G. DENNIS EDWARDS  
9 5 1

RENEWS 12/31/2005

RECEIVED BY

Umatilla County Surveyor

Date 2-05

Rec'd by KK

No. 05-38-A

**LEGEND:**

- FOUND 5/8" IRON REBAR, PLATS OF HIGHLAND VISTA, #1 & #2
- SET 5/8"X30" IRON REBAR WITH PLASTIC CAP #951
- ⊙ COMPUTED LOCATION

SURVEY FOR SANDY NEDDO  
IN LOTS 9 & 10, "HIGHLAND VISTA, #2", IN SE 1/4,  
SEC. 11, T 4 N, R 28 E, W.M., CITY OF HERMISTON,  
UMATILLA COUNTY, OREGON  
12/7/2004 JOB# S0412233  
EDWARDS SURVEYING P.O. BOX 763  
541-567-3336 HERMISTON, OREGON 97838  
DRAWN BY NJF