

NARRATIVE:


THE PURPOSE OF THIS SURVEY IS TO STAKE THAT TRACT OF LAND DEEDED TO JAMES AND TOBY SWANGER ON REEL 301, PAGE 250, FOR A PENDING SALE.

I BASED THIS SURVEY ON ONE DONE BY ME IN 2005 FOR CHOWNING WHICH WAS BASED ON A SURVEY BY FRALEY IN 1950. BEARINGS ARE TRUE BASED ON MY 2004 G.I.S. SURVEY FOR UMATILLA COUNTY IN THE CITY OF HERMISTON.

REGISTERED PROFESSIONAL LAND SURVEYOR

G. Dennis Edwards

OREGON
JULY 16, 1971
G. DENNIS EDWARDS
9 5 1
RENEWS 12/31/2007

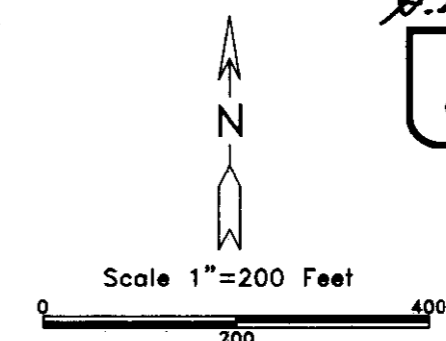

- LEGEND:**
- MONUMENT FOUND AS NOTED
 - ⊕ FND. 5/8" I. REBAR, MY 2005 SUR. FOR CHOWNING
 - SET 5/8"x30" IRON REBAR WITH PLASTIC CAP #951
 - ⊙ COMPUTED LOCATION
 - [000] OF RECORD, 1950 FRALEY SURVEY

SURVEY FOR TOBY SWANGER
IN SW 1/4, SEC. 9, T 4 N, R 28 E,
W.M., UMATILLA COUNTY, OREGON
03/13/2006 JOB# S0603042
EDWARDS SURVEYING P.O. BOX 763
541-567-3336 HERMISTON, OREGON 97838
DRAWN BY JMC RECEIVED BY

Umatilla County Surveyor

Date 3-06

Rec'd By JK

No. 06-44-A