



**NARRATIVE:**

THE PURPOSE OF THIS SURVEY IS TO TIE A GARAGE AND ITS EAVES WHICH IS LOCATED ON LOT 3, BLOCK 7, "HAT ROCK TRACTS", AND TO DESCRIBE THAT PORTION OF IT WHICH OVERLAPS ONTO LOT 2.  
 I SURVEYED THE LINE BETWEEN LOTS 2 AND 3 IN A 2005 SURVEY FOR DELANEY AND SEILAFF AND THIS SURVEY AND THE BEARINGS ARE BASED ON THAT SURVEY.

REGISTERED  
PROFESSIONAL  
LAND SURVEYOR

*G. Dennis Edwards*

OREGON  
JULY 16, 1971  
G. DENNIS EDWARDS  
9 5 1  
RENEWS 12/31/2007

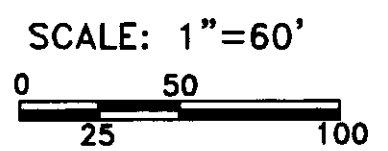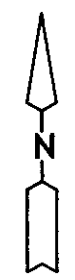

- LEGEND:**
- MONUMENTS FOUND AS NOTED
  - E FND 5/8" IRON REBAR SET BY ME IN 2005 SURVEY FOR DELANEY & SIELAFF
  - (000) PLAT OF "HAT ROCK TRACTS"

SURVEY FOR DOUG FEHRENBACHER & GEORGE ANDERSON  
 LOTS 2 & 3, BLK. 7, "HAT ROCK TRACTS",  
 IN NE 1/4, SEC. 15, T 5 N, R 29 E, W.M.,  
 UMATILLA COUNTY, OREGON  
 4/28/06 JOB# S0504062C  
 EDWARDS SURVEYING P.O. BOX 763  
 541-567-3336 HERMISTON, OREGON 97838  
 DRAWN BY NJF

RECEIVED BY  
Umatilla County Surveyor

Date 5-06  
 Rec'd by KK  
 No. 06-204-A