


Filed in City of
Hermiston Plat Book

Rec. 11-14-77

7c

SECTION TIES
ON HIGHLAND AVENUE
HERMISTON OREGON

Chris E. Robnett
Ore. Reg. #169

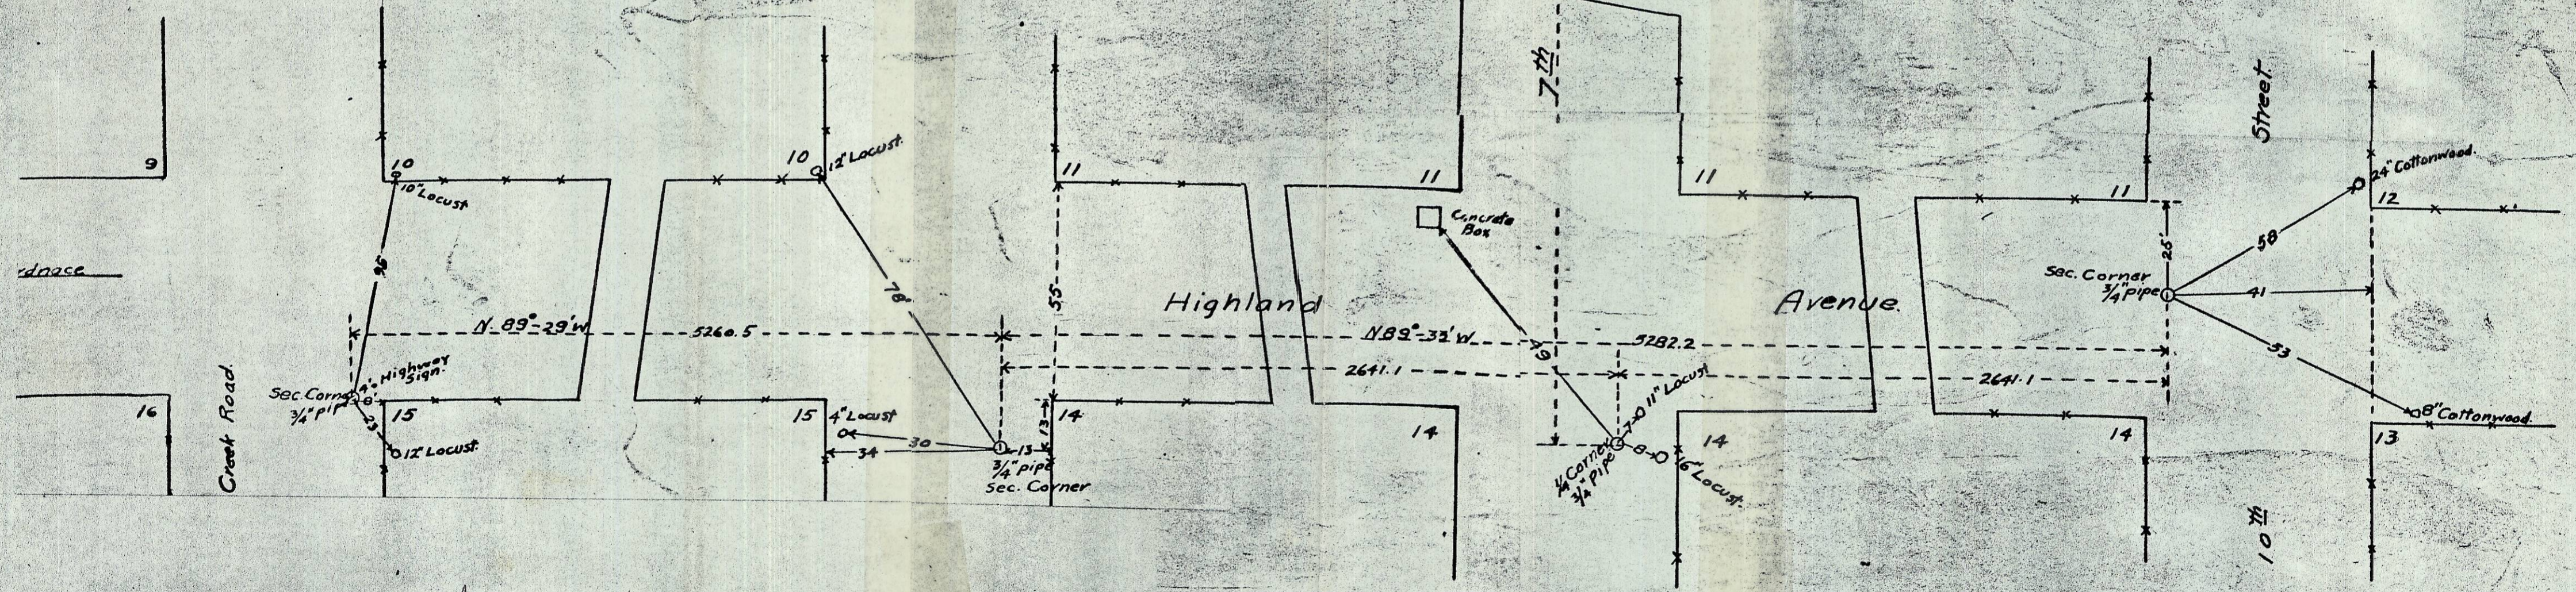

06-433-A

40 28 11 5/2