


Map of SURVEY
of a Portion of Reservation
Addn. Pendleton, Oregon.
By Geary Kimbrell Civ. Eng.

Scale 100 ft = 1 in.
TRUR32 ICC + 2DD

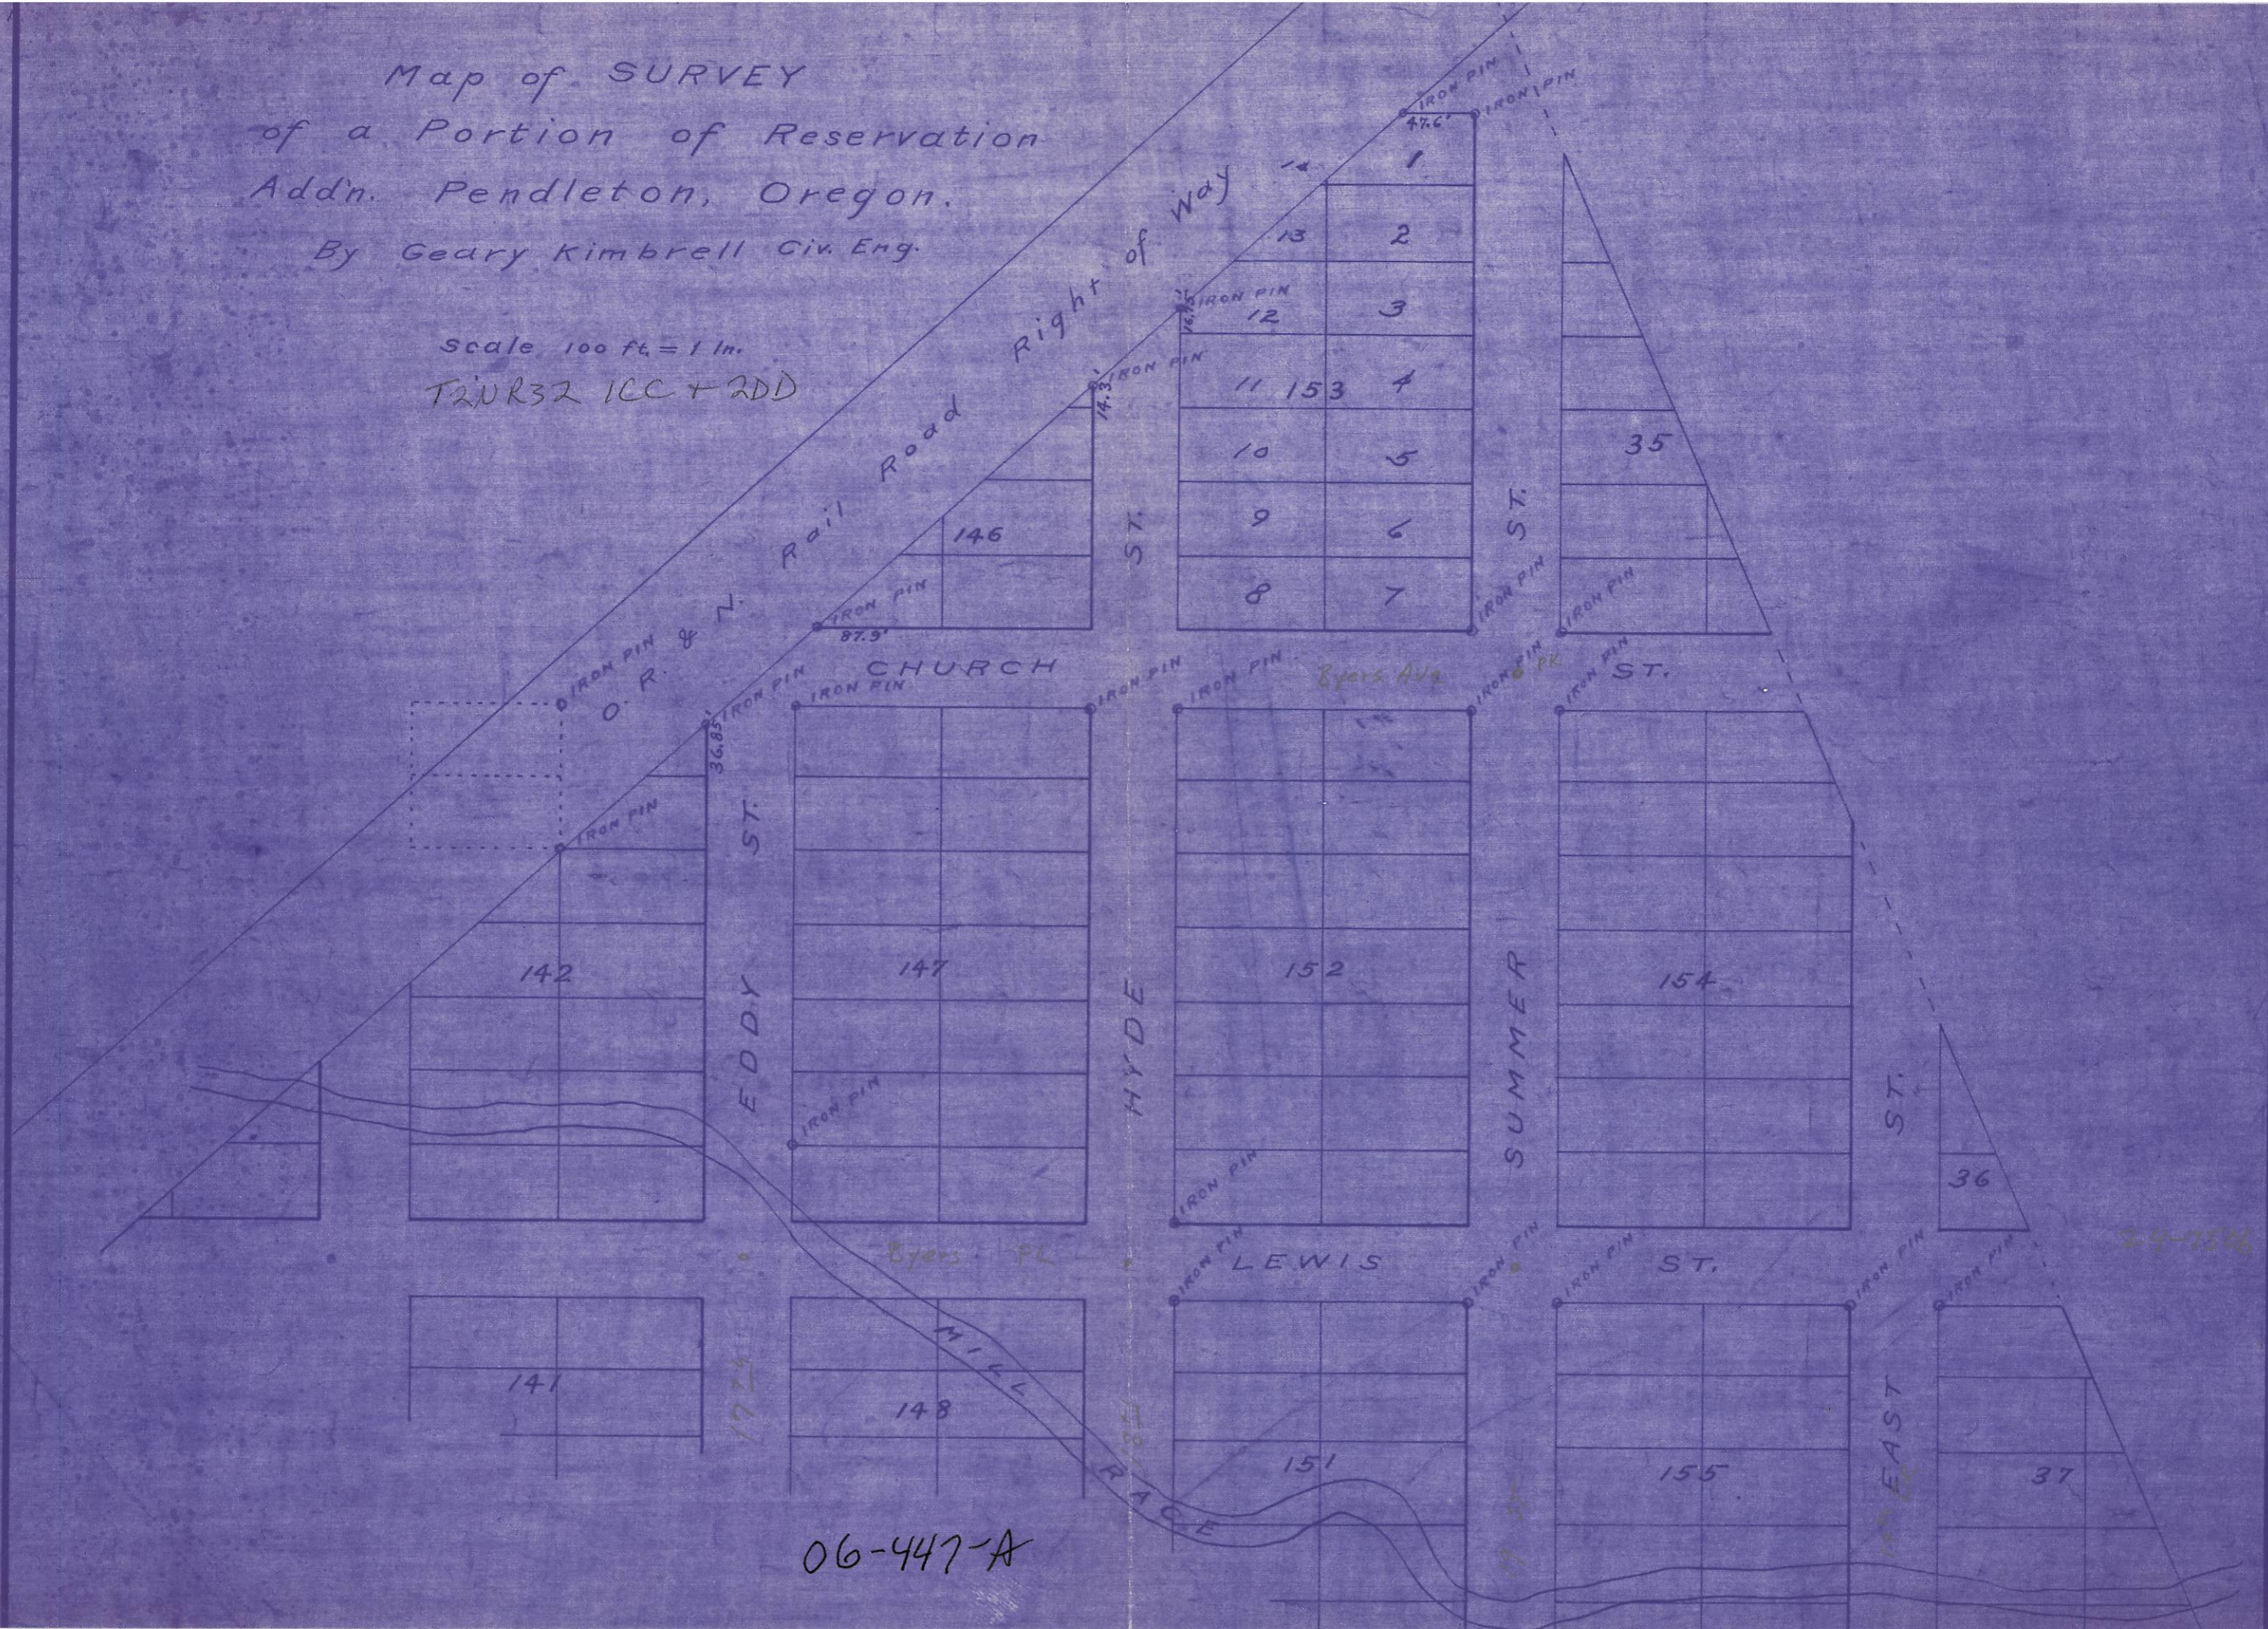

06-447-A

29-7506