


H-1-20

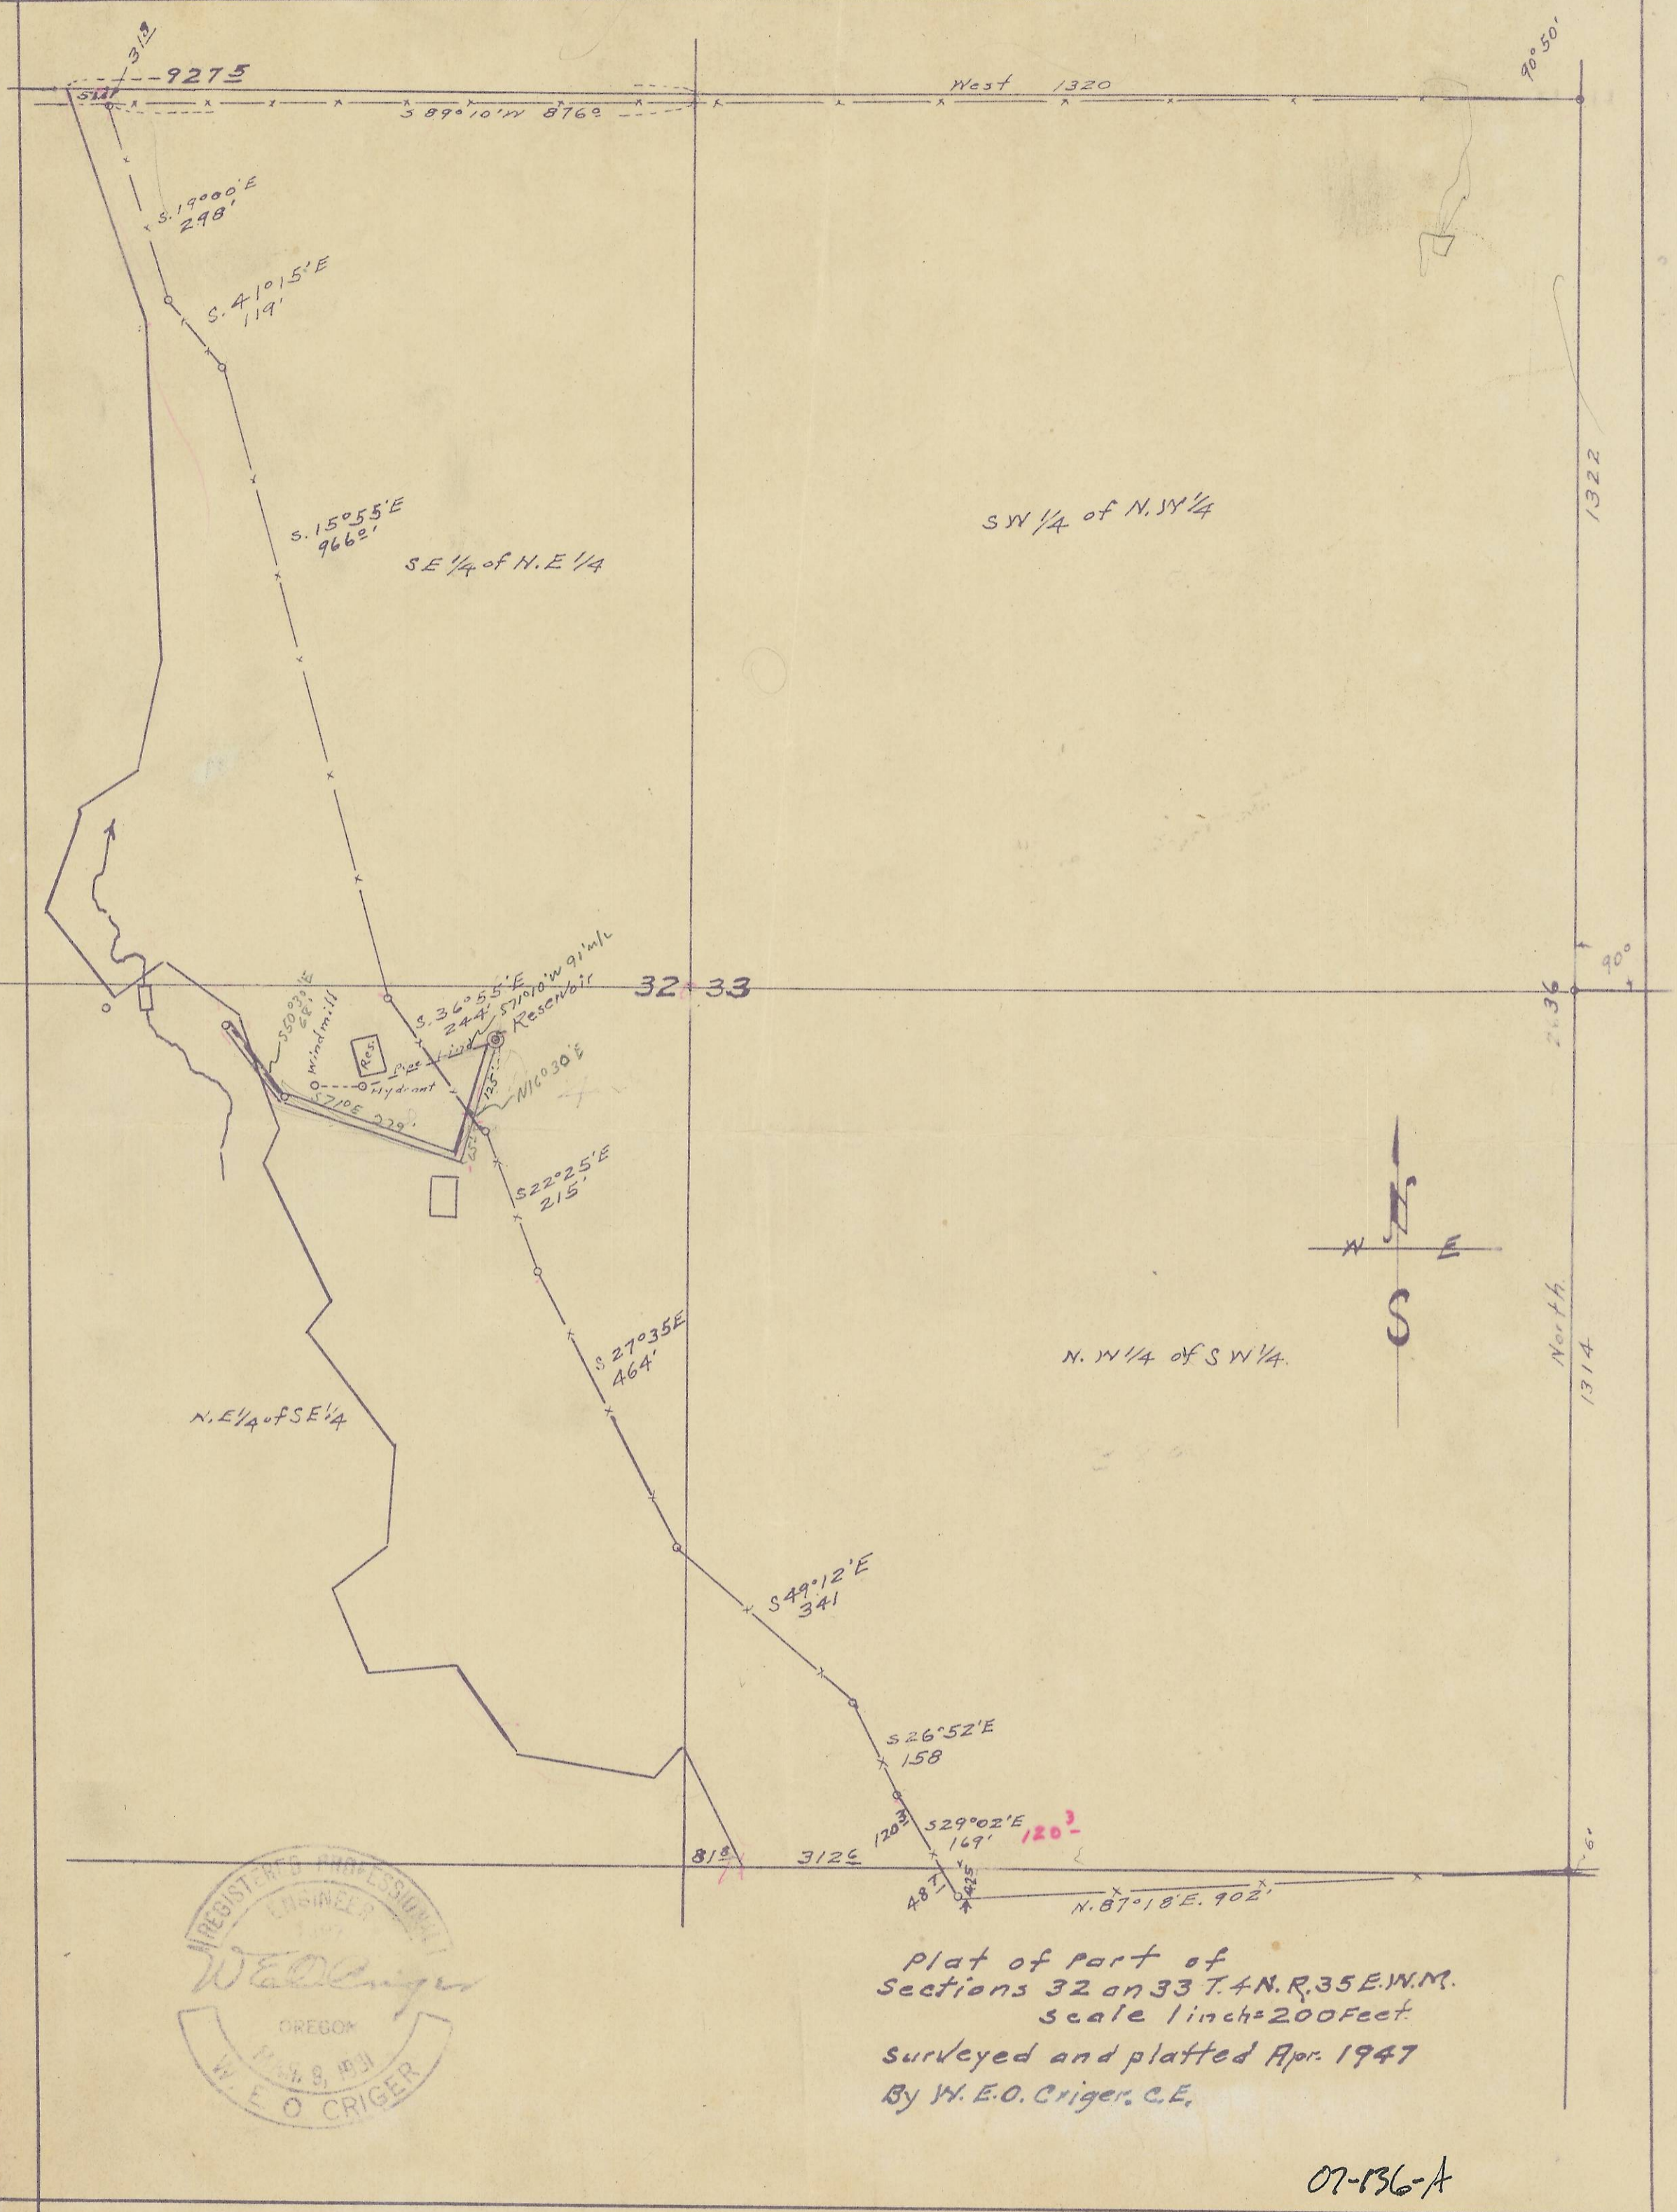

Plat of part of
 Sections 32 and 33 T.4N.R.35E.W.M.
 scale 1 inch = 200 feet
 surveyed and platted Apr. 1947
 By W. E. O. Criger, C.E.

07-136-A

10-111