


**SURVEYOR'S NARRATIVE:**

THE PURPOSE OF THIS SURVEY IS TO STAKE THE LINE BETWEEN TAX LOT 4301, MAP 4N28C AND TAX LOT 103, MAP 4N2833B SO PHOTOGRAPHS CAN BE TAKEN TO SHOW THE LOCATION OF SAID LINE IN RELATION TO AN EXISTING GRAVELED ROAD.

SAID LINE IS THE SECTION LINE BETWEEN SECTIONS 28 AND 33 WHICH I SURVEYED IN A 1992 MONUMENTATION SURVEY FOR UMATILLA COUNTY.

I WIGGLED IN ON SAID SECTION LINE WITH MY "SET 300 SOKKIA TOTAL STATION" AND SET THE MONUMENTS AS SHOWN.

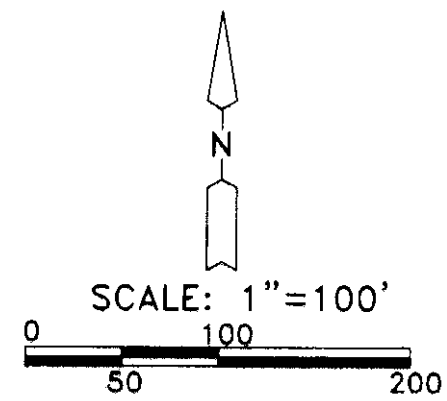

REGISTERED  
PROFESSIONAL  
LAND SURVEYOR

*G. Dennis Edwards*

OREGON  
JULY 16, 1971  
G. DENNIS EDWARDS  
9 5 1  
RENEWS 12/31/2011

**LEGEND:**

- FOUND TRUCK AXLE, ORIGINAL UNKNOWN
- ⊙ FOUND 2 3/8" B.C., ME 1992 COUNTY MONUMENTATION SURVEY
- SET 5/8"X30" IRON REBAR WITH PLASTIC CAP #951
- ⊙ SET PK NAIL IN AC PAVEMENT
- (000) OF RECORD, MY 1992 COUNTY MONUMENTATION SURVEY

SURVEY FOR FRANK MUELLER  
C/O GEORGE ANDERSON  
IN SW 1/4, SEC. 28, T 4 N, R 28 E, W.M.,  
UMATILLA COUNTY, OREGON  
11/30/2011 JOB# S1111065  
EDWARDS SURVEYING P.O. BOX 763  
541-567-3336 HERMISTON, OREGON  
DRAWN BY JMC

Umatilla County Surveyor  
Date 12-11  
Rec'd By KA  
11-135-A