


68152

68152

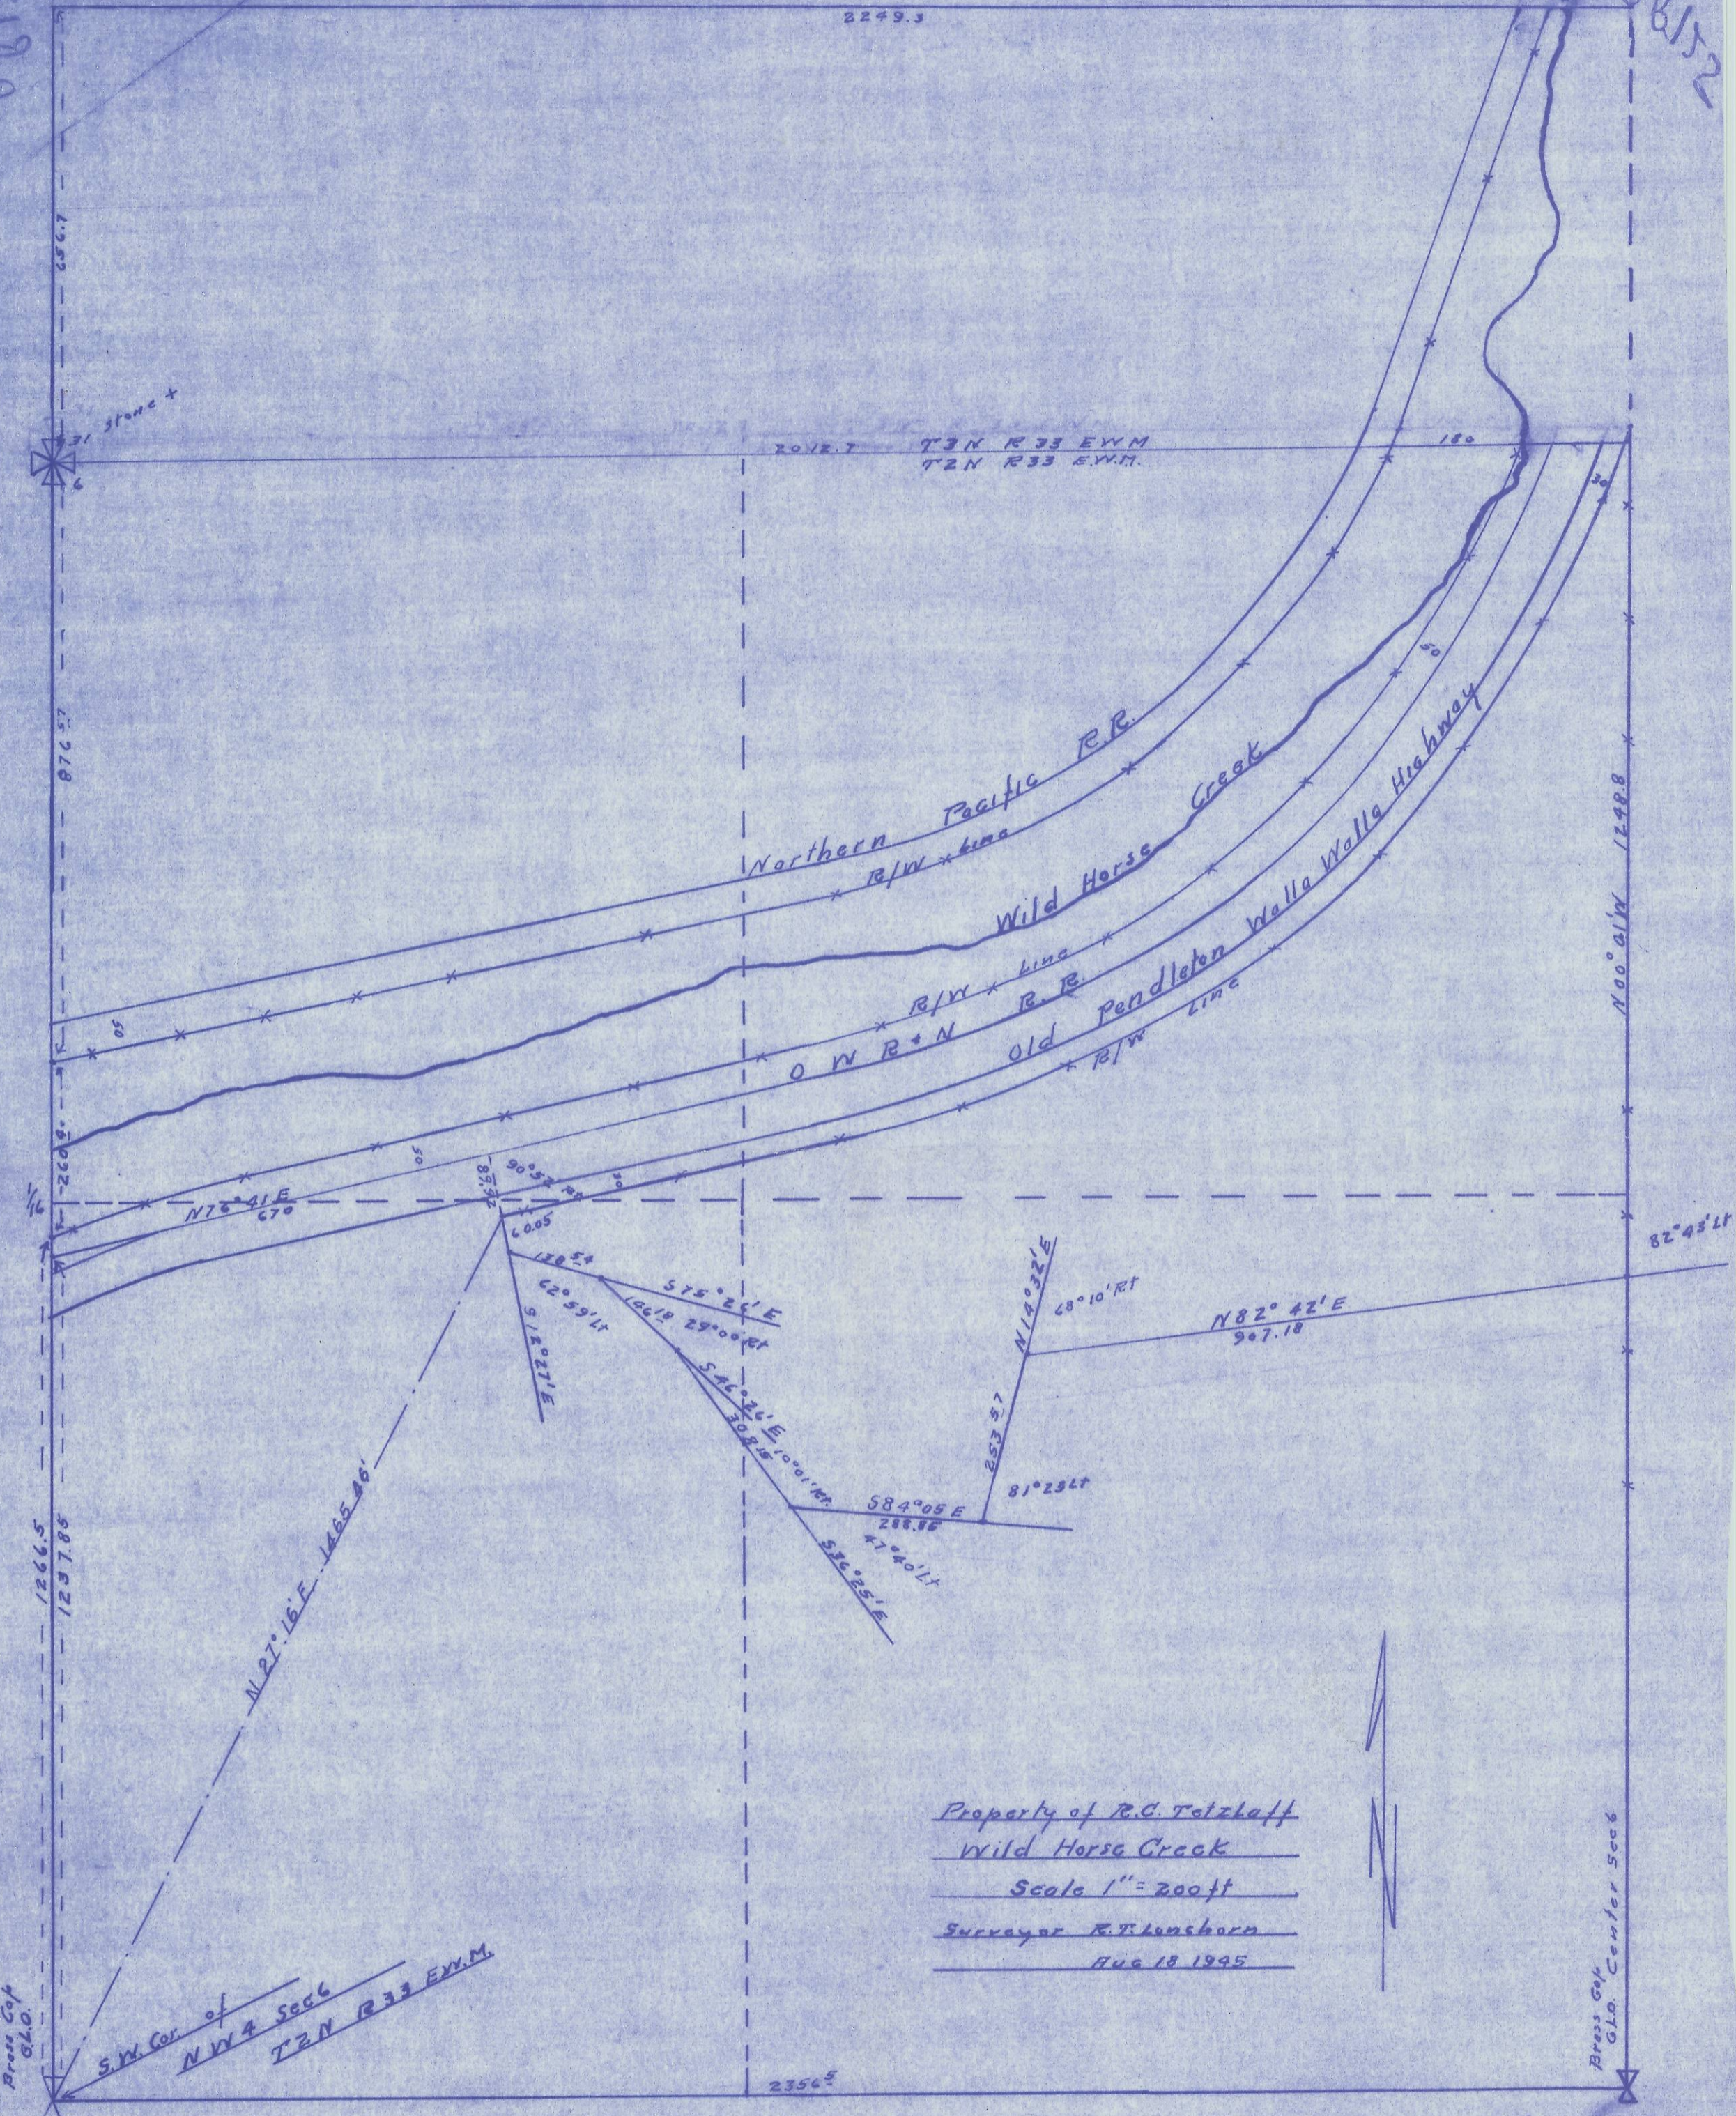

Property of R.C. Tetzlaff
 Wild Horse Creek
 Scale 1" = 200ft
 Surveyor R.T. Longhorn
 Aug 18 1945

NOTE
 The above Plat made by R.T. Longhorn, is made from notes taken by Mr. Longhorn while making a transit and tape survey of the property under my direction and supervision. I have examined the Plat and I hereby certify that it correctly represents the actual tract in a true and faithful manner to the best of my knowledge and belief.

[Signature]
 T2N R33
 Sec 68E 05-06

RECEIVED BY
 Umatilla County Surveyor
 Date: 5/23/2012
 Rec'd By: J. O'Connell
 No.: 12-078-A

68152