



VICINITY MAP

SCALE: 1" = 100'

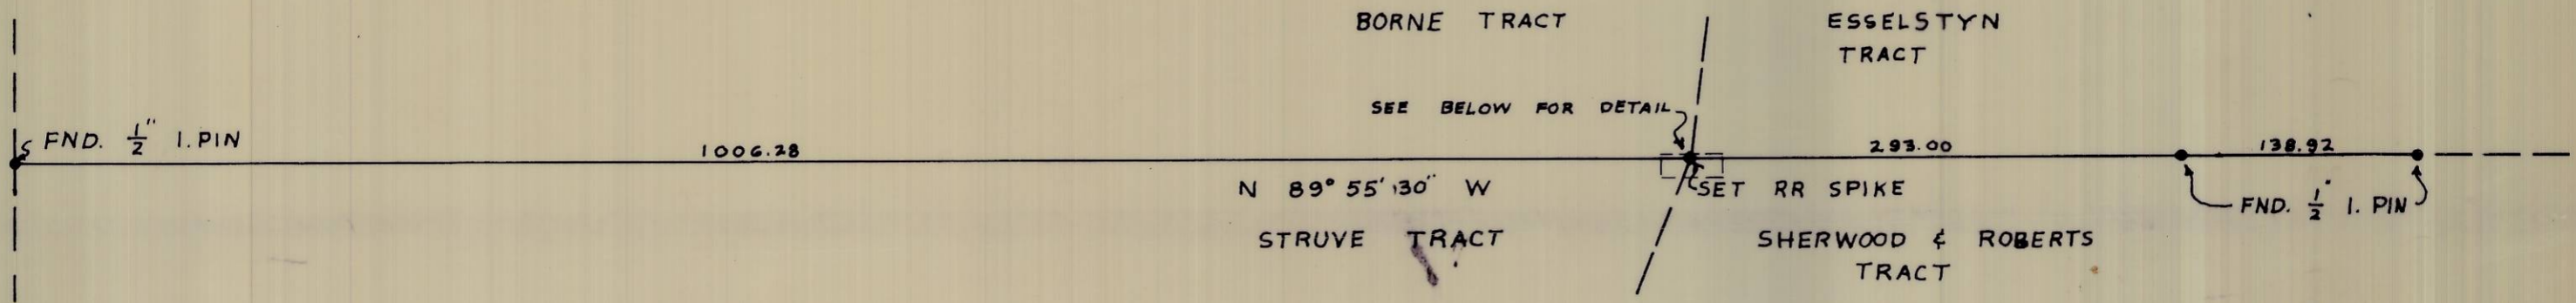

BRIDGE DETAIL

SCALE: 1" = 10'

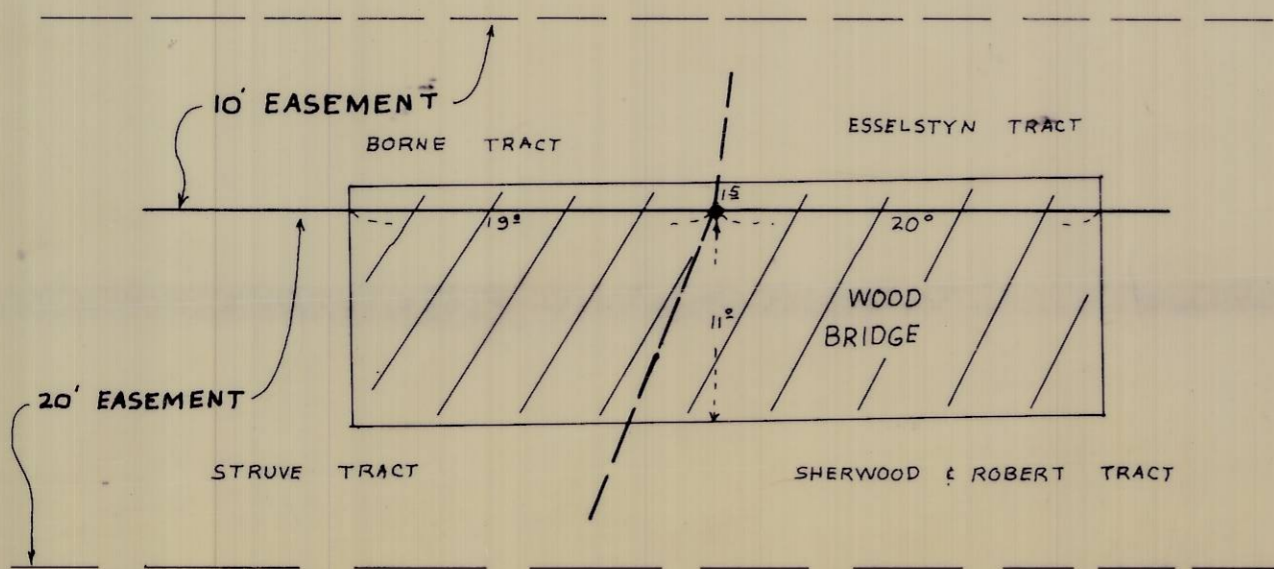

WAYNE HARRIS CO. INC.

SURVEY FOR
GILBERT PETTEYS
 PARCEL IN NW 1/4
 SECTION 16, T.2 N., R. 32 E.W.M.

SCALE	DATE	DRN. BY	DRNG. NO
AS SHOWN	10-29-73	DHK	73-259-A

II-A