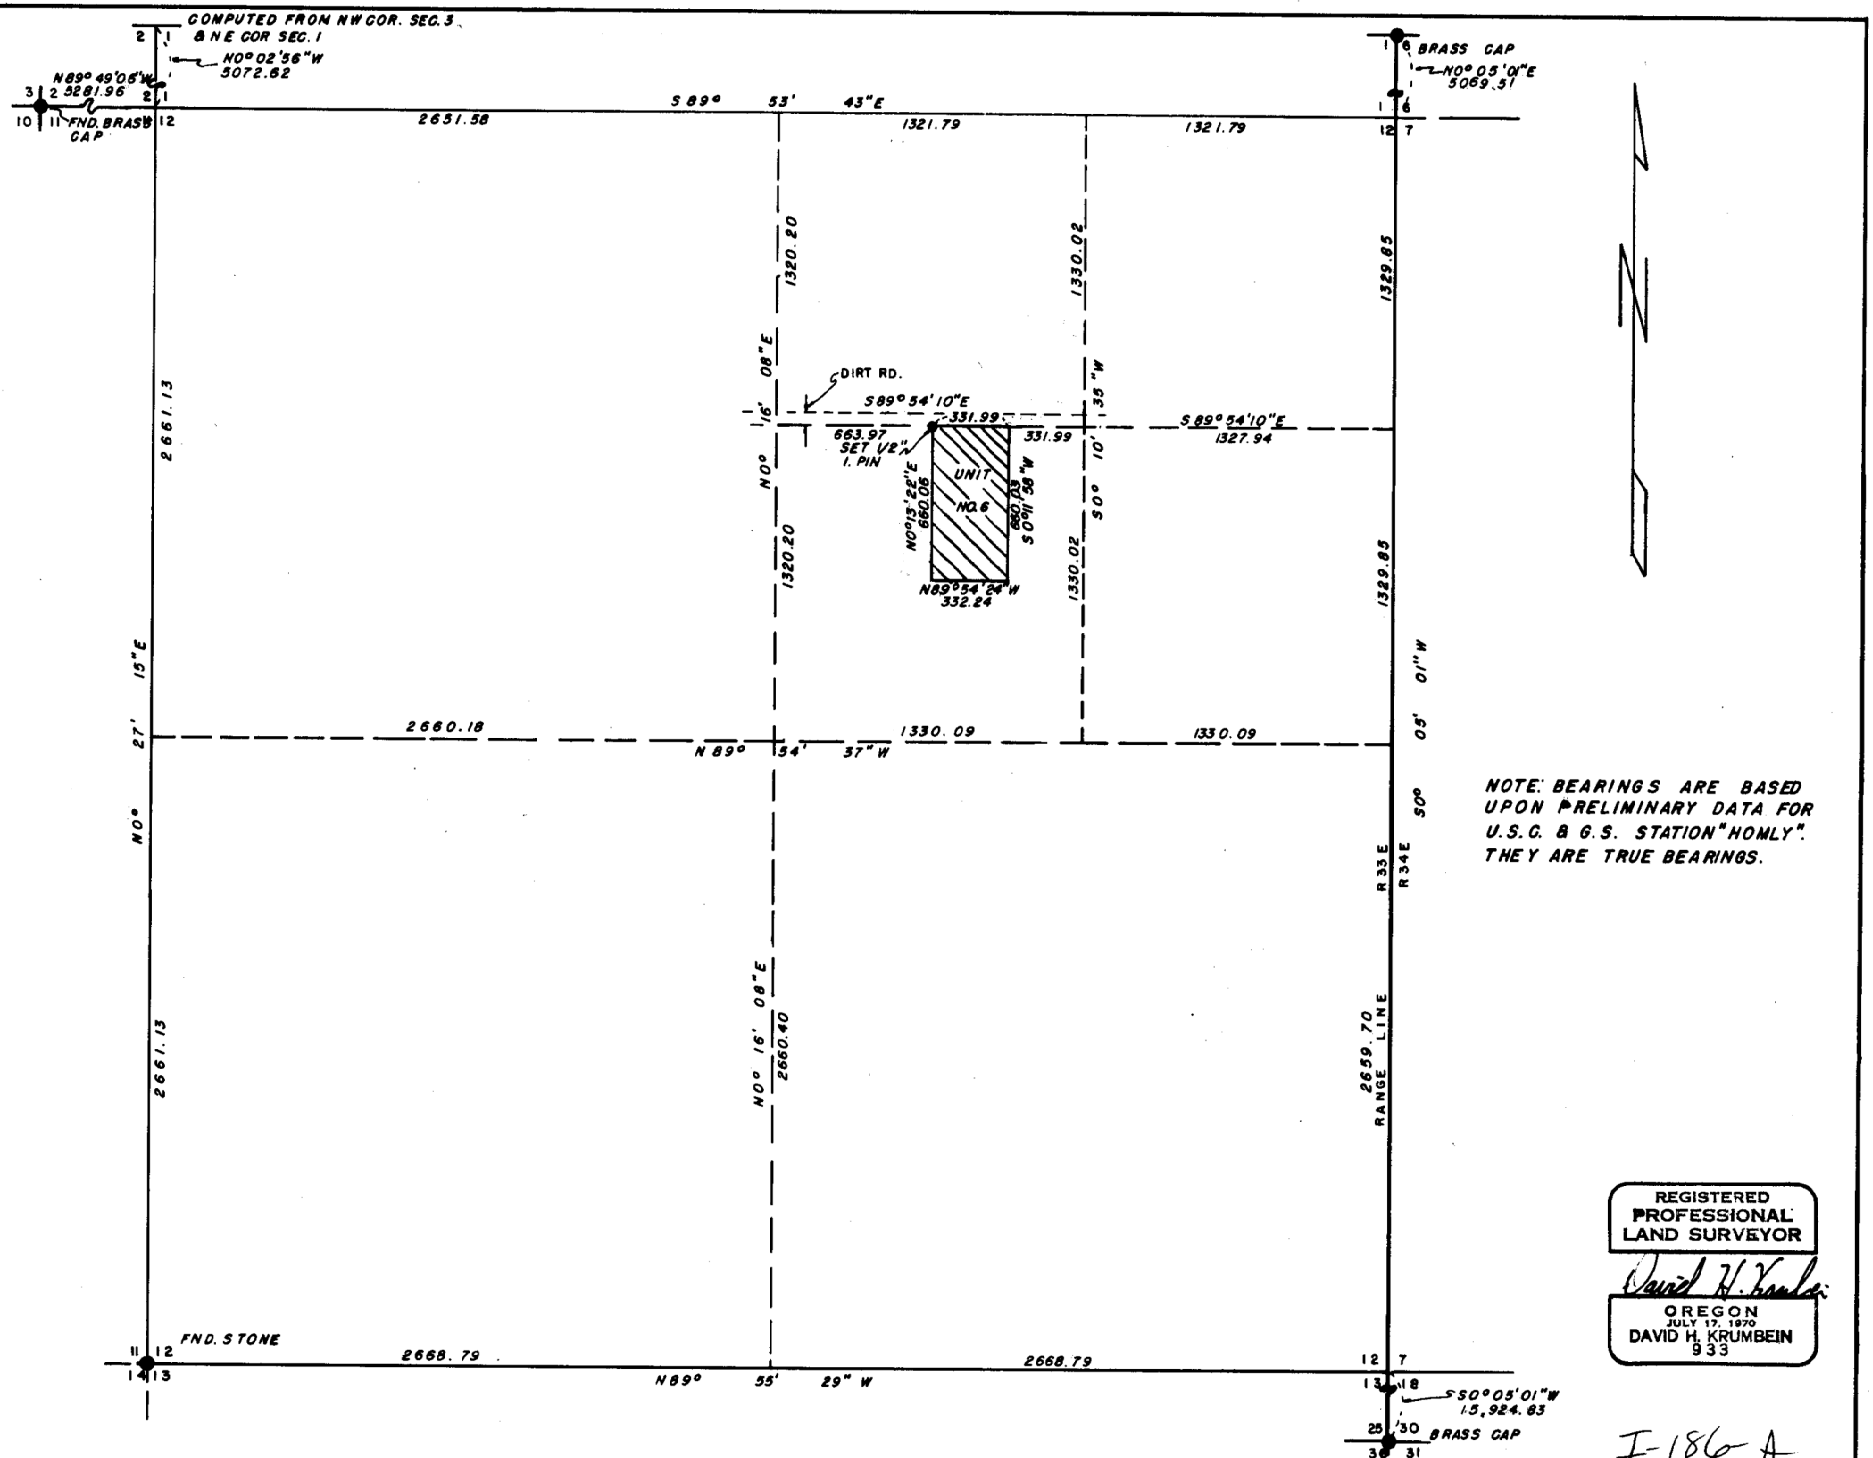

NOTE: BEARINGS ARE BASED UPON PRELIMINARY DATA FOR U.S.C. & G.S. STATION "HOMLY". THEY ARE TRUE BEARINGS.

REGISTERED PROFESSIONAL LAND SURVEYOR
David H. Krumbein
OREGON
JULY 17, 1970
DAVID H. KRUMBEIN
933

I-186 A

SURVEY FOR UMATILLA INDIAN AGENCY
HOUSING AUTHORITY — UNIT NO. 6
PARCEL IN NE 1/4 SEC. 12
T. 2 N., R33E. W.M.

WAYNE HARRIS CO. INC.
ENGINEERS SURVEYORS PENDLETON OREGON

SCALE	1" = 500'	DRN. BY	D.E.S.	DRNG. NO.
DATE	8-7-74	CKD. BY	DHK	74-278