



SCALE 1" = 200'

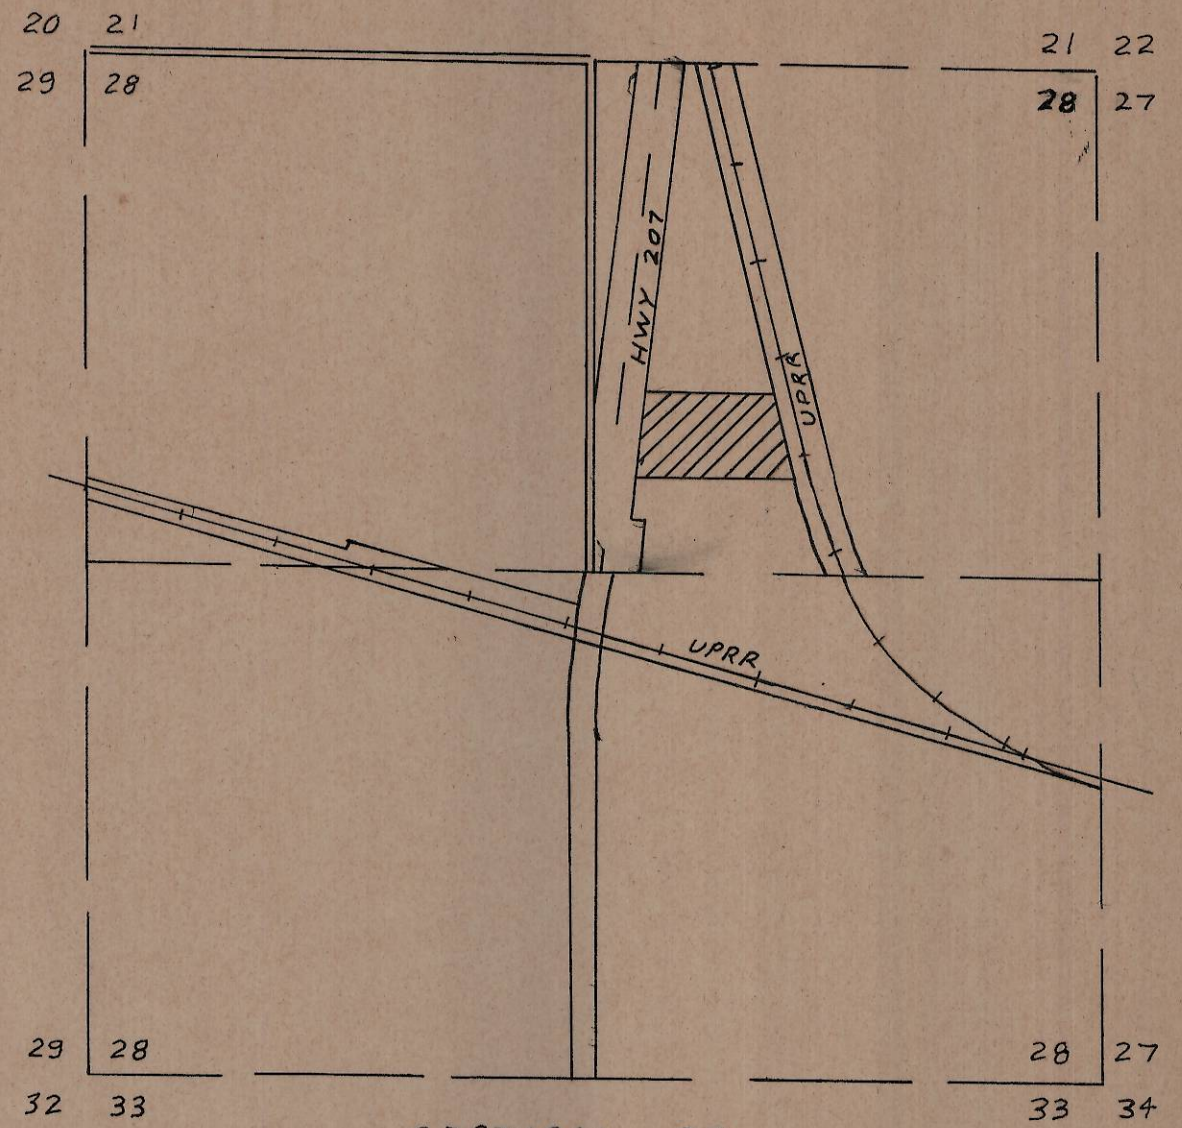

SECTION 28

SCALE 1" = 1000'

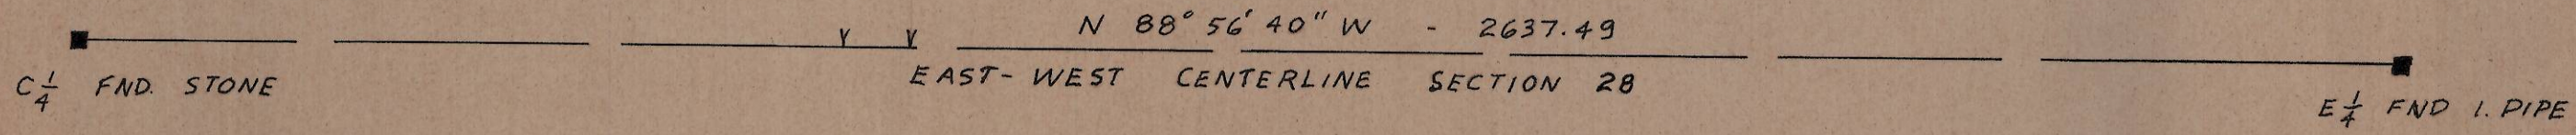

• INDICATES $\frac{5}{8}$ I. PIN SET
 BEARINGS ARE BASED UPON
 TIES TO NOS STATIONS. THOSE
 SHOWN ARE TRUE.

PROFESSIONAL
 LAND SURVEYOR
David H. Krumbin
 DAVID H. KRUMBEIN
 933

J-121-A

SURVEY for BETTS
 PARCEL in NE 1/4
 SECTION 28, T.4N., R.28E.W.M.

WAYNE HARRIS CO. INC.		ENGINEERS SURVEYORS PENDLETON		
SCALE	AS SHOWN	DRN. BY	DHK	DRNG NO
DATE	7-25-75	GKD BY	GTP	75-340A